IREDELL COUNTY HEALTH DEPARTMENT

STATESVILLE 704-878-5305 MOORESVILLE 704-664-5281

IMPROVEMENT PERMIT / AUTHORIZATION TO CONSTRUCT / OPERATION PERMIT / EXISTING SYSTEM INSPECTION

PERMIT# 89501 PIN# 4702 683390 PT DATE 9/21/00

OWNER OR CONTRACTOR Silver Wave Prop. PHONE: Business (704) 532-6625 Home

ADDRESS 5651 Mancoc Rd Charlotte NC 28212

LOCATION Old Mtn, Rt Lewis Ferry, Lt Ratcliff on Corner

SUBDIVISION Ratcliff BLOCK / SECTION — LOT 5 LOT AREA .66 Ac SITE CLASS. PS DESIGN FLOW 360 L.T.A.R. 0.3

Septic Tank: 1000 Gallons; STB 1012 Date 8/29/00
Pump Tank: Gallons; PT Date
Pump Make: Model Serial No.
Nitrification Field: No Fields 1 Square Feet 1200 Linear Feet 400
No Lines 4 @ 100' Trench Width 36" Max Trench Bottom Depth 24" Gravel Depth 12"

☒ New System ☐ Repair, System Type: I. II. III. IV. V. VI
System Description: Grav. Conv.
Repair System Description: Grav. 25% Red.
Maintenance Agreement Required: ☐ Yes ☒ No

☐ House/Mod. Home ☒ Mobile Home ☐ Business ☐ Other
No. Bedrooms 3 No. Bathrooms 2 No. Employees


☐ Slab ☒ Crawl Space ☐ Basement w/plumbing ☐ Basement wo/plumbing

Water Supply: ☐ Individual ☒ Public ☐ Community

Comments:/Conditions:


Scale 1:40

INITIAL SITE SKETCH

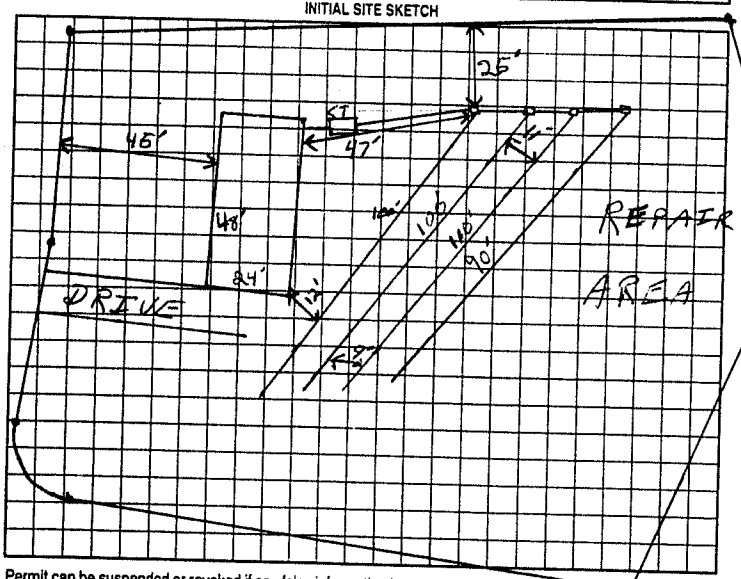

Comments:/Conditions:

AS BUILT SKETCH

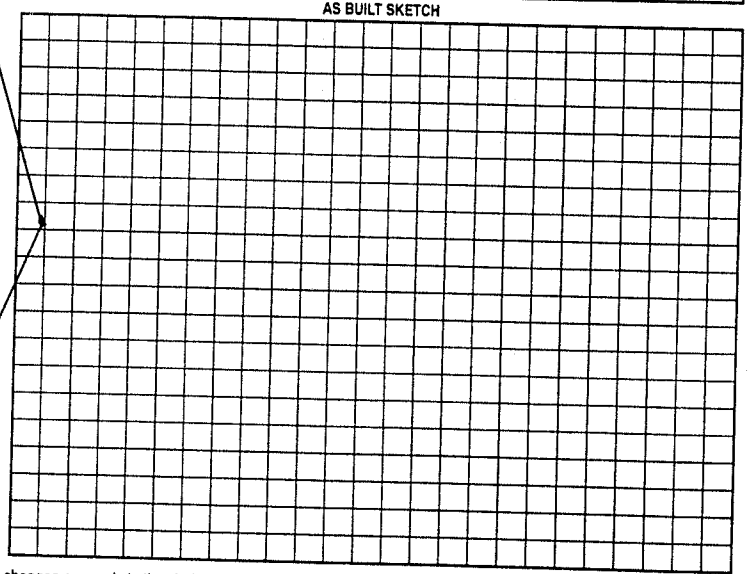

Permit can be suspended or revoked if any false information is supplied toward securing the permit, any unauthorized changes are made to the site/any unauthorized changes are made in the installation of the system. Improvement Permit with plat valid without expiration, Improvement Permit with site plan valid for sixty months. Authorization to Construct is valid for a period equal to that of Improvement Permit – not to exceed sixty months.

Signed: Renee A Rowe date

Improvement Permit by: RSE date 9/21/00

Authorization to Construct by: RSE date 9/21/00

Installed by: A-1 Back hoe

Operation Permit by: RSE date 9/28/00

Existing System Inspection by: date

HEALTH DEPT. COPY: WHITE OWNER COPY (FINAL): YELLOW OWNER COPY (INITIAL): PINK