IREDELL COUNTY HEALTH DEPARTMENT

Statesville Office (704) 878-5305 Mooresville Office (704) 660-3625 PERMIT # 181409 BF

IMPROVEMENT PERMIT / AUTHORIZATION TO CONSTRUCT / OPERATION PERMIT / EXISTING SYSTEM

PIN # 4702608001

APPLICANT: Clayton Homes APPLICANT ADDRESS: 2026 Northside Dr.

SITE ADDRESS: 1064 Lewis Ferry Rd. PHONE: 704-239-3693 ALT. PHONE: N/A

SITE DIRECTIONS: Hwy 70W TL old Mtn Rd. TR Lewis Ferry Rd.

SUBDIVISION: N/A SECTION: N/A LOT # N/A LOT AREA: 1.92 acres DESIGN FLOW: 360gpd L.T.A.R.: Existing

Septic Tank	Existing (gal)	STB		Date		☐ New System ☐ Repair ☐ Expansion	System Type: I II III IV V VI	☑ Residence	No. Bedrooms 3
Pump Tank	(gal)	PT		Date		System Description:	Conv.	☐ Business	No. Persons
Pump Make		Model		Serial #		Repair System Description:		☐ Other	No. Employees
# Nitrification Fields	1	# Lines	Ex	Linear Ft:	Ex	Maintenance Agreement Required:	☐ YES ☑ NO	☐ Slab	☑ Crawl Space
Trench Width	Ex	Max. Trench Bottom Depth	Ex	Gravel Depth	Ex	☑ GRAVITY	☐ PRESSURE	☐ Basement w/plumbing	☐ Basement w/o plumbing


Water Supply: ☑ Private ☐ Public ☐ Community

Comments / Conditions:

- Maintain a minimum of 5' between home foundation & all components of septic tank system

INITIAL SITE SKETCH

AS BUILT SKETCH

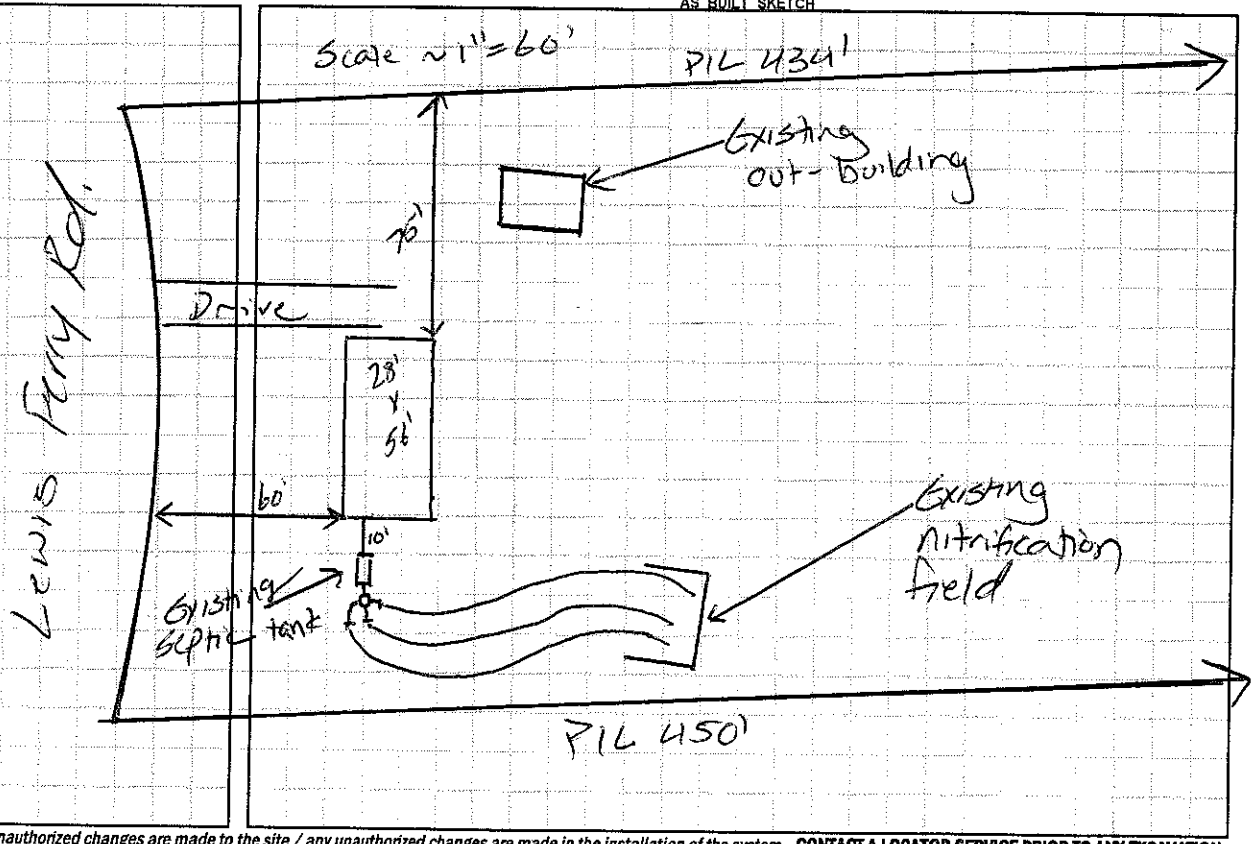

Permit can be suspended or revoked if any false information is supplied toward securing the permit / any unauthorized changes are made to the site / any unauthorized changes are made in the installation of the system. **CONTACT A LOCATOR SERVICE PRIOR TO ANY EXCAVATION**

☐ **IMPROVEMENT PERMIT** ***with plat*** *valid without expiration.* ☐ **IMPROVEMENT PERMIT** ***with site plan*** *valid for 60 mos.* ☐ **AUTHORIZATION TO CONSTRUCT** *valid for period equal to IMPROVEMENT PERMIT--not to exceed 60 mo.*

Owner / Applicant Signature: [signature] Date: 10/22/13 Installed by:

IMPROVEMENT PERMIT by: Date: OPERATION PERMIT by: Date:

AUTHORIZATION TO CONSTRUCT by: Date: Existing System Inspected by: [signature] Date: 10-17-13

Health Dept. Copy - WHITE Applicant (Final Approval) - YELLOW Applicant (Conditional Approval) - PINK