IREDELL COUNTY HEALTH DEPARTMENT

STATESVILLE 704-878-5305 MOORESVILLE 704-664-5281

IMPROVEMENT PERMIT / AUTHORIZATION TO CONSTRUCT / OPERATION PERMIT / EXISTING SYSTEM INSPECTION

PERMIT# 86059 PIN# 4702 65 3706 832-8805 pager DATE Nov 30 99

OWNER OR CONTRACTOR Raymond MAyfield PHONE: Business ~~871-3611~~ Home

ADDRESS

LOCATION Old MT Rd 5th (R) E Lewis Ferry Cross Eutola To W Lewis Ferry Lot on Left off Road 4th on Left

SUBDIVISION BLOCK / SECTION LOT LOT AREA SITE CLASS 03 DESIGN FLOW 480 L.T.A.R. .4

Septic Tank: Existing 1000 Gallons; STB Date

Pump Tank: Gallons; PT Date

Pump Make: Model Serial No.

Nitrification Field: No Fields 1 Square Feet 1200 Linear Feet 400

No Lines 5 TOTAL Trench Width 36" Max Trench Bottom Depth 36"

☐ New System ☐ Repair System Type: I (II) III IV V VI

System Description: Conv GRAVITY

Repair System Description: Same 25% Red. Possible

Maintenance Agreement Required: ☐ Yes ☒ No

Gravel Depth 12"

☐ Slab ☒ Crawl Space ☐ Basement w/plumbing ☐ Basement wo/plumbing

☐ House/Mod. Home ☒ Mobile Home ☐ Business ☐ Other

No. Bedrooms 4 No. Bathrooms 3 No. Employees

Water Supply: ☒ Individual ☐ Public ☐ Community Well


Comments:/Conditions:

(1) Tie INTo old Line With New drop Box
Add 2 Lines 50 ft EACh
(2) Keep Min. 100 ft From bored well
(3) Keep New drive off of Septic AREA

Comments:/Conditions:

(4) Inspect outlet "T" & Replace if needed

INITIAL SITE SKETCH

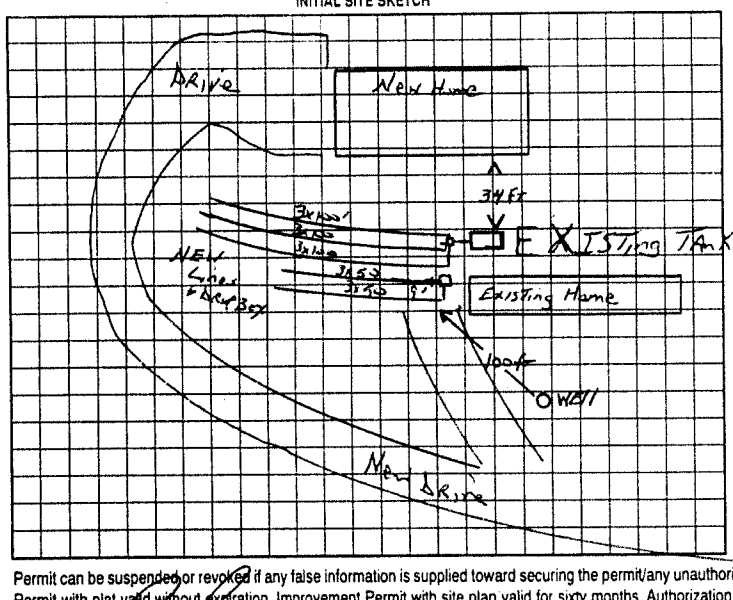

AS BUILT SKETCH

System installed As shown
one Distribution box used

Permit can be suspended or revoked if any false information is supplied toward securing the permit/any unauthorized changes are made to the site/any unauthorized changes are made in the installation of the system. Improvement Permit with plat valid without expiration. Improvement Permit with site plan valid for sixty months. Authorization to Construct is valid for a period equal to that of Improvement Permit – not to exceed sixty months.

Signed: date 1-14-2000 Installed by: Forest Shifford

Improvement Permit by: Jc Potter date Nov 30 99 Operation Permit by: Jc Potter date May 31, 2000

Authorization to Construct by: Jc Potter date Nov 30 99 Existing System Inspection by: date

HEALTH DEPT. COPY. WHITE OWNER COPY (FINAL) YELLOW OWNER COPY (INITIAL) PINK