IREDELL COUNTY HEALTH DEPARTMENT

STATESVILLE 704-878-5305 MOORESVILLE 704-664-5281

IMPROVEMENT PERMIT / AUTHORIZATION TO CONSTRUCT / OPERATION PERMIT / EXISTING SYSTEM INSPECTION

PERMIT# 84390 PIN# 4762683390 DATE Nov 10 99

OWNER OR CONTRACTOR Silver Wave Prop. PHONE: Business 532 6625 Home

ADDRESS 5551 Monroe Rd Charlotte, NC

LOCATION Old Mt Rd South ® Lewis Ferry ® Eufola Lot on Left before Lamb Rd.

SUBDIVISION RAE Field BLOCK / SECTION LOT 1 LOT AREA 1.03 Ac SITE CLASS. PS DESIGN FLOW 360 L.T.A.R. 3

Septic Tank: 1000 Gallons; STB 794 Date 3-22-00
Pump Tank: Gallons; PT Date 10-30-01
Pump Make: Model Serial No.
Nitrification Field: No Fields 1 Square Feet 1200 Linear Feet 400
No Lines 5@80 Trench Width 36" Max Trench Bottom Depth 36" Gravel Depth 12"

☒ New System ☐ Repair System Type: I (II) III. IV. V. VI
System Description: Conv GRAVITY
Repair System Description: 25% Reduction/ Part
Maintenance Agreement Required: ☐ Yes ☒ No


☐ House/Mod. Home No. Bedrooms 3
☒ Mobile Home No. Bathrooms 2
☐ Business No. Employees
☐ Other
☐ Slab ☒ Crawl Space ☐ Basement w/plumbing ☐ Basement wo/plumbing

Water Supply: ☐ Individual ☒ Public ☐ Community

Comments:/Conditions:

Comments /Conditions: ZABEL FILTER
SYSTEM CHANGED TO 25% REDUCTION 4 LINES
EQUALING 320', INSTALLED AS SHOWN WITH MARKER

INITIAL SITE SKETCH

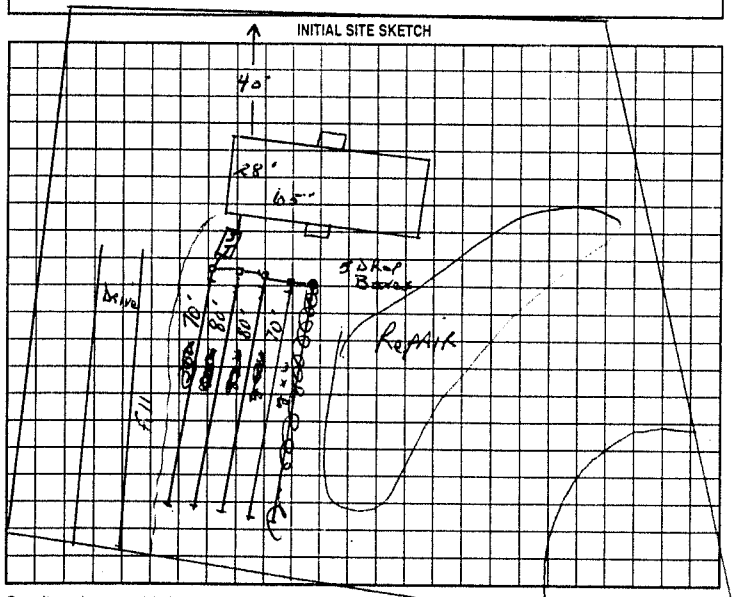

AS BUILT SKETCH

Permit can be suspended or revoked if any false information is supplied toward securing the permit/any unauthorized changes are made to the site/any unauthorized changes are made in the installation of the system. Improvement Permit with plat valid without expiration. Improvement Permit with site plan valid for sixty months. Authorization to Construct is valid for a period equal to that of Improvement Permit – not to exceed sixty months.

Signed: James J Strickland date Nov 19 99 Installed by: DELTA INGR

Improvement Permit by: C Potter date Nov 10 99 Operation Permit by: Jerry Cook RS date 12-27-01

Authorization to Construct by: C Potter date Nov 10 99 Existing System Inspection by: date

HEALTH DEPT. COPY: WHITE OWNER COPY (FINAL): YELLOW OWNER COPY (INITIAL): PINK