28m A1

IREDELL COUNTY HEALTH DEPARTMENT

STATESVILLE 704-878-5305 MOORESVILLE 704-664-5281

IMPROVEMENT PERMIT / AUTHORIZATION TO CONSTRUCT / OPERATION PERMIT / EXISTING SYSTEM INSPECTION

PERMIT# 89507 PIN# 4702683390 PT DATE 7/12/00

OWNER OR CONTRACTOR SILVERWAVE PROP. PHONE: Business 532-6625 Home

ADDRESS 5551 MONROE RD. CHARLOTTE NC 28212

LOCATION OLD MTN RD - TL LEWIS FERRY - TL RAEFIELD - ON LT CORNER

SUBDIVISION RAEFIELD BLOCK / SECTION LOT 14 LOT AREA .68AC SITE CLASS PS DESIGN FLOW 360GPD L.T.A.R. .30PD/PT2

Septic Tank: 1000 Gallons; STB 1012 Date 4 4 2000
Pump Tank: Gallons; PT Date
Pump Make: Model Serial No.
Nitrification Field: No Fields 1 Square Feet 900 1200 Linear Feet 300 400
No Lines 4@15' Trench Width 36" Max Trench Bottom Depth 24" Gravel Depth N/A

☑ New System ☐ Repair System Type: I, II, (III), IV, V, VI
System Description: GRAVITY ~~INNOVATIVE~~ CONV.
Repair System Description: ~~PUMP/GRAV~~ GRAV. SAME
Maintenance Agreement Required: ☐ Yes ☑ No Reduction
☐ Slab ☑ Crawl Space ☐ Basement w/plumbing ☐ Basement wo/plumbing


☑ House/Mod. Home No. Bedrooms 3
☑ Mobile Home No. Bathrooms 2
☐ Business No. Employees
☐ Other

Water Supply: ☐ Individual ☑ Public ☐ Community


Comments/Conditions: 1) SITE WAS VERY THICK AT TIME OF LAYOUT. 2) SYSTEM MAY BE CHANGED TO CONVENTIONAL IF SITE IS CLEARED AND APPROVED BY HEALTH DEPARTMENT.

Comments/Conditions: 7.21.2000. SITE VISIT & Reflagged To 4 Lines @100ft Conventional Sep

INITIAL SITE SKETCH (NOT TO SCALE)

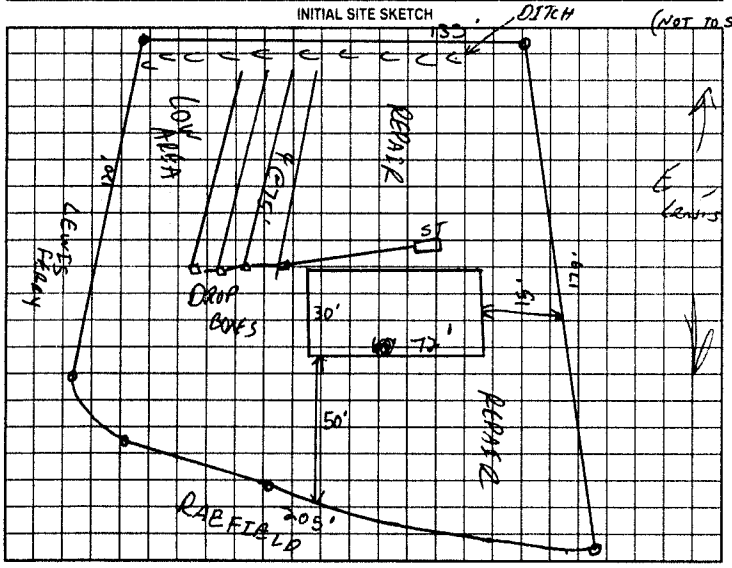

AS BUILT SKETCH

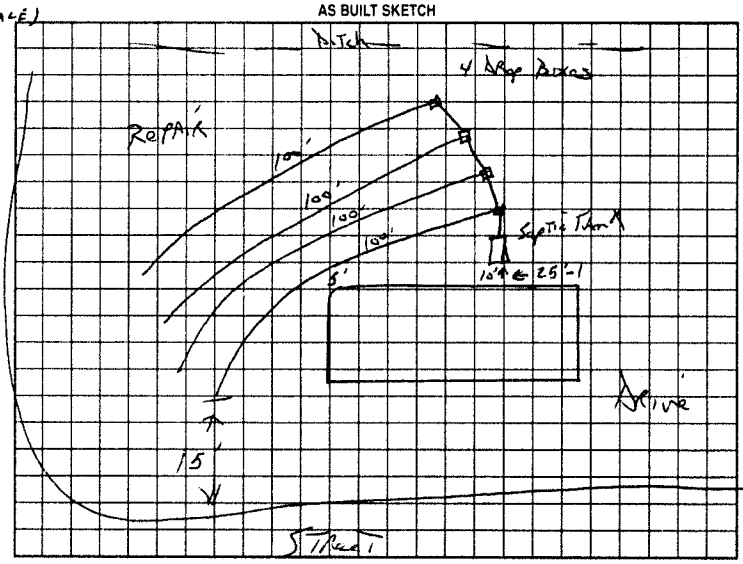

Permit can be suspended or revoked if any false information is supplied toward securing the permit/any unauthorized changes are made to the site/any unauthorized changes are made in the installation of the system. Improvement Permit with plat valid without expiration. Improvement Permit with site plan valid for sixty months. Authorization to Construct is valid for a period equal to that of Improvement Permit – not to exceed sixty months.

Signed: [signature] date 7/14/00 Installed by: Al Backhoe

Improvement Permit by: [signature] RS date 7/12/00 Operation Permit by: [signature] date July 24 2000

Authorization to Construct by: [signature] RS date 7/12/00 Existing System Inspection by: date

HEALTH DEPT. COPY: WHITE OWNER COPY (FINAL): YELLOW OWNER COPY (INITIAL): PINK