IREDELL COUNTY HEALTH DEPARTMENT

STATESVILLE 704-878-5305 (CI) MOORESVILLE 704-664-5281

IMPROVEMENT PERMIT / AUTHORIZATION TO CONSTRUCT / OPERATION PERMIT / EXISTING SYSTEM INSPECTION

PERMIT# 11720 PIN# 4702-68-2098 DATE 7-7-03

OWNER OR CONTRACTOR Silver Wave Properties PHONE: Business 704-532-6527 Home

ADDRESS 5551 MONROE RD CHARLOTTE, NC 28212

LOCATION 40 W, (1) OMR, (2) LEWIS FERRY, (3) EUFOLA, 2ND LOT ON LEFT

SUBDIVISION RAE FIELD BLOCK / SECTION LOT 3 LOT AREA 1.02 AC SITE CLASS. DESIGN FLOW 360 L.T.A.R. .25

Septic Tank: 1000 Gallons; STB 1012 Date 4-30-04

Pump Tank: [redacted] Gallons; PT Date

Pump Make: Model Serial No.

Nitrification Field: No. Fields 1 Square Feet EQ 1440 Linear Feet 240'

No. Lines 8 X 30' Trench Width 24" Max Trench Bottom Depth 36" Gravel Depth N/A

(X) New System ☐ Repair System Type: I, II, (III), IV, V, VI

System Description: GRAV PANEL

Repair System Description: LP PANEL

Maintenance Agreement Required: ☐ Yes ☐ No

☐ House/Mod. Home No. Bedrooms 3

(X) Mobile Home No. Bathrooms 2

☐ Business No. Employees

☐ Other


☐ Slab (X) Crawl Space ☐ Basement w/plumbing ☐ Basement wo/plumbing

Water Supply: ☐ Individual (X) Public ☐ Community


Comments:/Conditions: (1) SYSTEM & HOUSE ARE COMPLETELY FLAGGED OUT (2) INSTALL LINES ON CONTOURS & MAINTAIN SETBACKS (3) INSTALL 8 LINES, 30' LONG, USING 2 DIST. BOX'S WITH SPEED LEVELERS & ONE FLOW DIVIDER

Comments:/Conditions: TEE. PUT OR INSTALL 7 PANEL BLOCKS IN EACH LINE TO TOTAL 56 PANEL BLOCKS; (4) BOTH FRONT CORNERS OF THE HOUSE IS 87' OFF FRONT LINE; TUFF TITE FILTER & MANIFOLD

"NOT TO SCALE" INITIAL SITE SKETCH

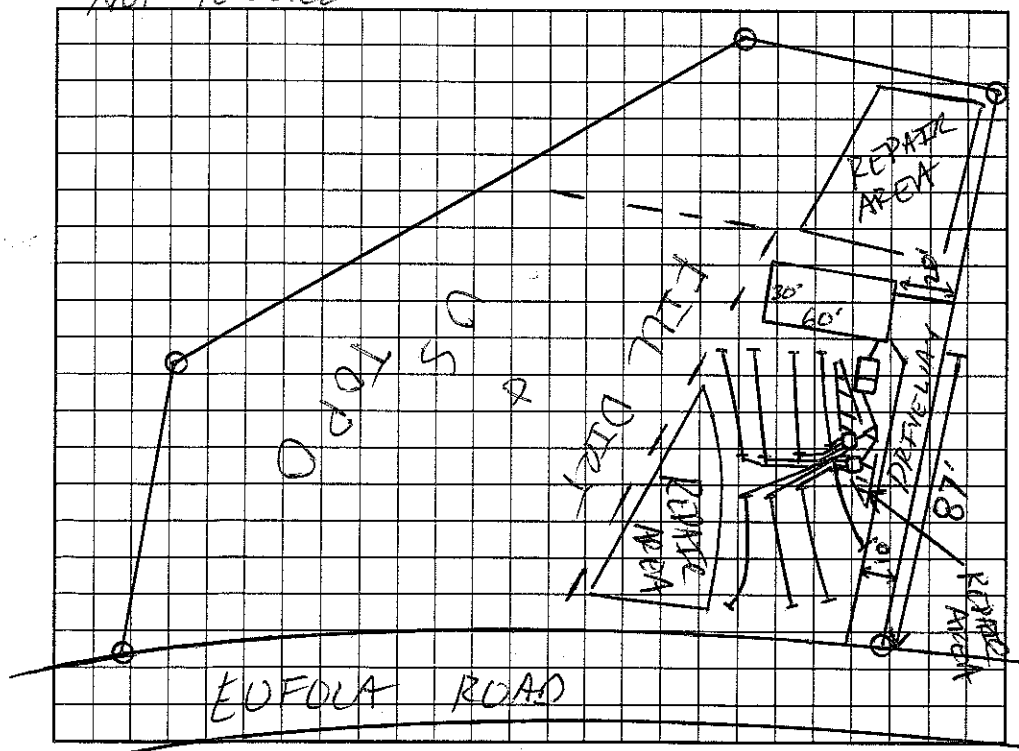

AS BUILT SKETCH

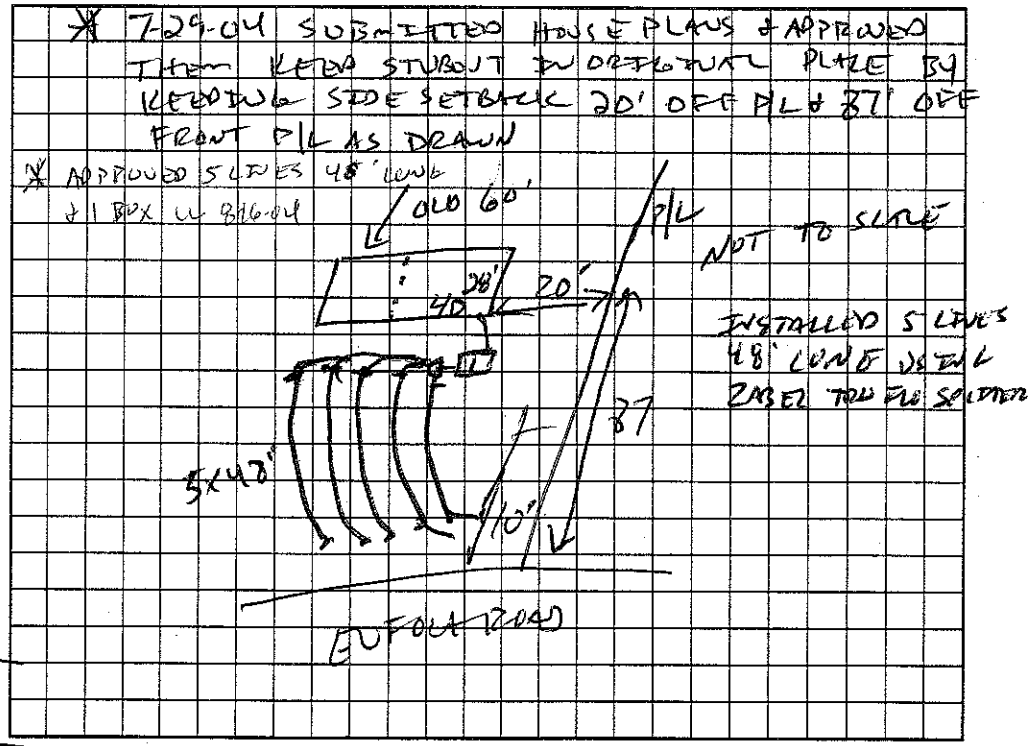

Permit can be suspended or revoked if any false information is supplied toward securing the permit/any unauthorized changes are made to the site/any unauthorized changes are made in the installation of the system. Improvement Permit with plat valid without expiration. Improvement Permit with site plan valid for sixty months. Authorization to Construct is valid for a period equal to that of Improvement Permit – not to exceed sixty months.

Signed: James J Barkley date 7-7-03 Installed by: A-1 BACKHOE

Improvement Permit by: RS date 7-7-03 Operation Permit by: RS date 8-17-04

Authorization to Construct by: RS date 7-7-03 Existing System Inspection by: date

HEALTH DEPT. COPY: WHITE OWNER COPY (FINAL): YELLOW OWNER COPY (INITIAL): PINK