IREDELL COUNTY HEALTH DEPARTMENT

THIS PERMIT VOIDS PREVIOUS ISSUED 11-14-2000

STATESVILLE 704-878-5305 MOORESVILLE 704-664-5281

IMPROVEMENT PERMIT / AUTHORIZATION TO CONSTRUCT / OPERATION PERMIT / EXISTING SYSTEM INSPECTION

PERMIT# 92683 PIN# 4702 68 3390 DATE 6-9-01

OWNER OR CONTRACTOR SILVERWAVE PROPERTIES PHONE: Business (704) 532-6525 Home

ADDRESS 5551 MONROE ROAD, CHARLOTTE, NC 28212

LOCATION I-40 W, TL OLD MTN. RD, TR LEWIS FERRY RD, TL RAEFIELD DR, 2ND LOT ON RIGHT

SUBDIVISION RAEFIELD BLOCK / SECTION LOT 7 LOT AREA 1.01 ACRES SITE CLASS PS DESIGN FLOW 360 L.T.A.R. 0.30 GPD/FT²

Septic Tank: 1000 Gallons: STB 312 Date 3-12-01
Pump Tank: Gallons: PT Date
Pump Make: Model Serial No.
Nitrification Field: No Fields 1 Square Feet 1200 Linear Feet 400
No Lines FOUR Trench Width 36" Max Trench Bottom Depth 36" Gravel Depth 12"

☑ New System ☐ Repair System Type: I II III IV V VI
System Description: CONVENTIONAL GRAVITY
Repair System Description: CONVENTIONAL PUMP
Maintenance Agreement Required: ☐ Yes ☑ No
☐ Slab ☑ Crawl Space ☐ Basement w/plumbing ☐ Basement wo/plumbing


☐ House/Mod. Home No. Bedrooms 3
☑ Mobile Home No. Bathrooms 2
☐ Business No. Employees
☐ Other

Water Supply: ☐ Individual ☐ Public ☐ Community

Comments:/Conditions:

Comments:/Conditions: SYSTEM INSTALLED AS SHOWN WITH POLYLOK FILTER JMARLOR

INITIAL SITE SKETCH

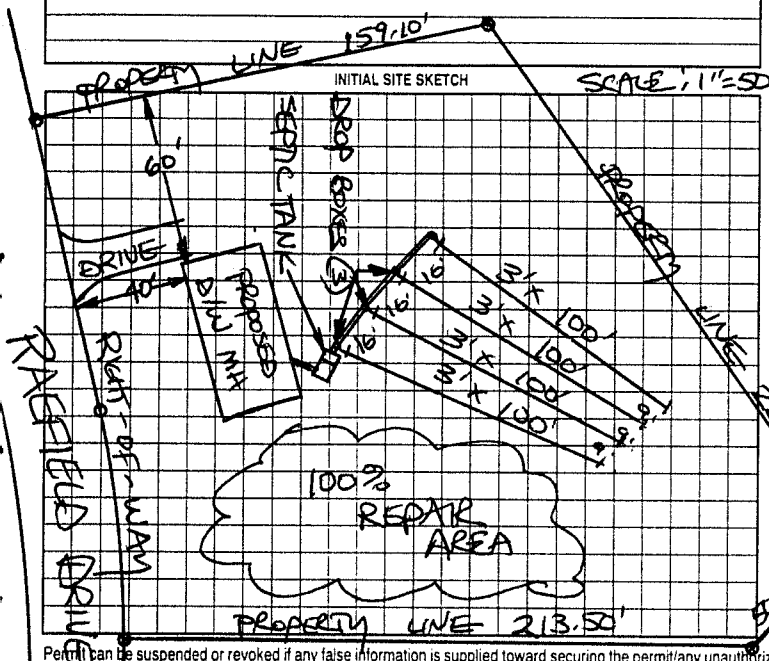

AS BUILT SKETCH

Permit can be suspended or revoked if any false information is supplied toward securing the permit/any unauthorized changes are made to the site/any unauthorized changes are made in the installation of the system. Improvement Permit with plat valid without expiration. Improvement Permit with site plan valid for sixty months. Authorization to Construct is valid for a period equal to that of Improvement Permit – not to exceed sixty months.

Signed: James J. Barkley date

Improvement Permit by: STEVE HEDRICK date 6-9-01

Authorization to Construct by: STEVE HEDRICK date 6-9-01

Installed by: DELLINGER

Operation Permit by: Jim Cook EST date 6-14-01

Existing System Inspection by: date

HEALTH DEPT. COPY: WHITE OWNER COPY (FINAL): YELLOW OWNER COPY (INITIAL): PINK