Redraw 50.00 Paid 8-16-00

IREDELL COUNTY HEALTH DEPARTMENT

STATESVILLE 704-878-5305 MOORESVILLE 704-664-5281

IMPROVEMENT PERMIT / AUTHORIZATION TO CONSTRUCT / OPERATION PERMIT / EXISTING SYSTEM INSPECTION

PERMIT# 90938 PIN# 4702683390 PT DATE 8/15/00

OWNER OR CONTRACTOR SILVERWAVE PROP. PHONE: Business 532-6625 Home

ADDRESS 5551 MONROE RD. CHARLOTTE NC 28212

LOCATION OLD MT. RD. TL LEWIS FERRY. TL RAEFIELD. 2nd ON LT

SUBDIVISION RAEFIELD BLOCK / SECTION LOT 13 LOT AREA .69AC SITE CLASS PS DESIGN FLOW 360GPD L.T.A.R. .36GPD/FT

Septic Tank: 1000 Gallons; STB 312 Date 7/11/00
Pump Tank: Gallons; PT Date
Pump Make: Model Serial No.
Nitrification Field: No Fields 1 Square Feet 900 Linear Feet 300
No Lines 6@50' Trench Width 36" Max Trench Bottom Depth 29"

☑ New System ☐ Repair System Type: I, II, III, IV, V, VI
System Description: GRAVITY INNOVATIVE
Repair System Description: PUMP/GRAV. SAME
Maintenance Agreement Required: ☐ Yes ☑ No
Gravel Depth ☐ Slab ☑ Crawl Space ☐ Basement w/plumbing ☐ Basement wo/plumbing


☑ House/Mod. Home No. Bedrooms 3
☐ Mobile Home No. Bathrooms 3
☐ Business No. Employees
☐ Other

Water Supply: ☐ Individual ☑ Public ☐ Community

Comments:/Conditions:

1" = 50'

INITIAL SITE SKETCH

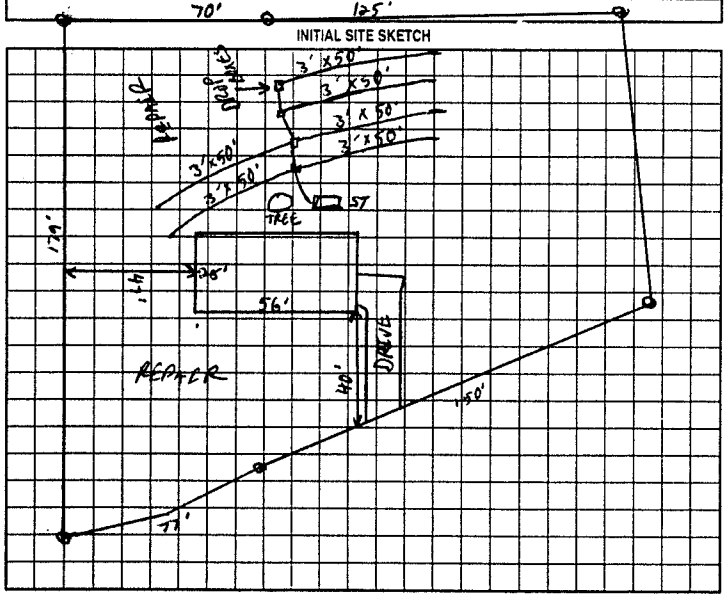

Comments:/Conditions:

AS BUILT SKETCH

Permit can be suspended or revoked if any false information is supplied toward securing the permit/any unauthorized changes are made to the site/any unauthorized changes are made in the installation of the system. Improvement Permit with plat valid without expiration. Improvement Permit with site plan valid for sixty months. Authorization to Construct is valid for a period equal to that of Improvement Permit – not to exceed sixty months.

Signed: Debbie Cashion date 8/15/00 Installed by: CRAIG THOMPSON

Improvement Permit by: C. Ayers RS date 8/15/00 Operation Permit by: C. Ayers RS date 8/22/00

Authorization to Construct by: C. Ayers RS date 8/15/00 Existing System Inspection by: date

HEALTH DEPT. COPY: WHITE OWNER COPY (FINAL): YELLOW OWNER COPY (INITIAL): PINK