IREDELL COUNTY HEALTH DEPARTMENT

STATESVILLE 704-878-5305 MOORESVILLE 704-664-5281

IMPROVEMENT PERMIT / AUTHORIZATION TO CONSTRUCT / OPERATION PERMIT / EXISTING SYSTEM INSPECTION

PERMIT# ~~106076~~ 138159 PIN# 4702-68-4254 DATE 5/15/02

OWNER OR CONTRACTOR ~~Roger S. Morrison~~ Freedom Homes, Statesville Home ~~(704) 880-8279~~ (704) 873-8179

ADDRESS ~~132 Amos Lake Drive~~ Statesville N.C. 28677

LOCATION I-40 W Old Mtn Rd (R) on Lewis Ferry Rd, (L) on Raefield Drive, lot on right

SUBDIVISION Raefield BLOCK / SECTION — LOT 8 LOT AREA .60 Ac. SITE CLASS P5 DESIGN FLOW 480 L.T.A.R. .30 gal/ft²

Septic Tank: 1,000 Gallons; STB ~~500~~ 1000 960 Date

Pump Tank: Gallons; PT Date

Pump Make: Model Serial No.

Nitrification Field: No Fields 1 Square Feet 1600 Linear Feet 540'

No Lines 7 Trench Width 36" Max Trench Bottom Depth 36" Gravel Depth 12"

☒ New System ☐ Repair System Type: I (II) III, IV, V, VI

System Description: Gravity Conventional

Repair System Description: Gravity/Pump/50% Reduction

Maintenance Agreement Required: ☐ Yes ☒ No

☐ House/Mod. Home ☒ Mobile Home ☐ Business ☐ Other

No. Bedrooms 4 No. Bathrooms 2 No. Employees

☐ Slab ☒ Crawl Space ☐ Basement w/plumbing ☐ Basement wo/plumbing

Water Supply: ☐ Individual ☒ Public ☐ Community

Comments/Conditions: (1) Install lines on Contour (2) Maintain proper Setbacks


Comments/Conditions: Int. Rt. Quick 4 Flow-Rite Tee

31'— 68


20 1— 102'

2 D-Boxes w/speed levelers

INITIAL SITE SKETCH

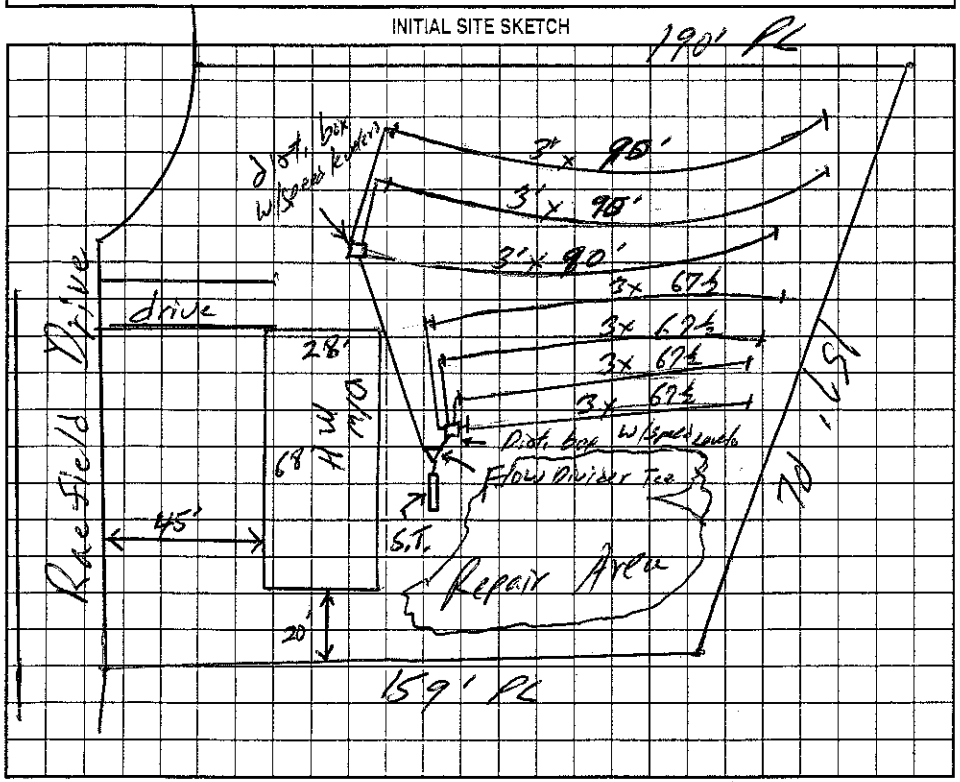

AS BUILT SKETCH

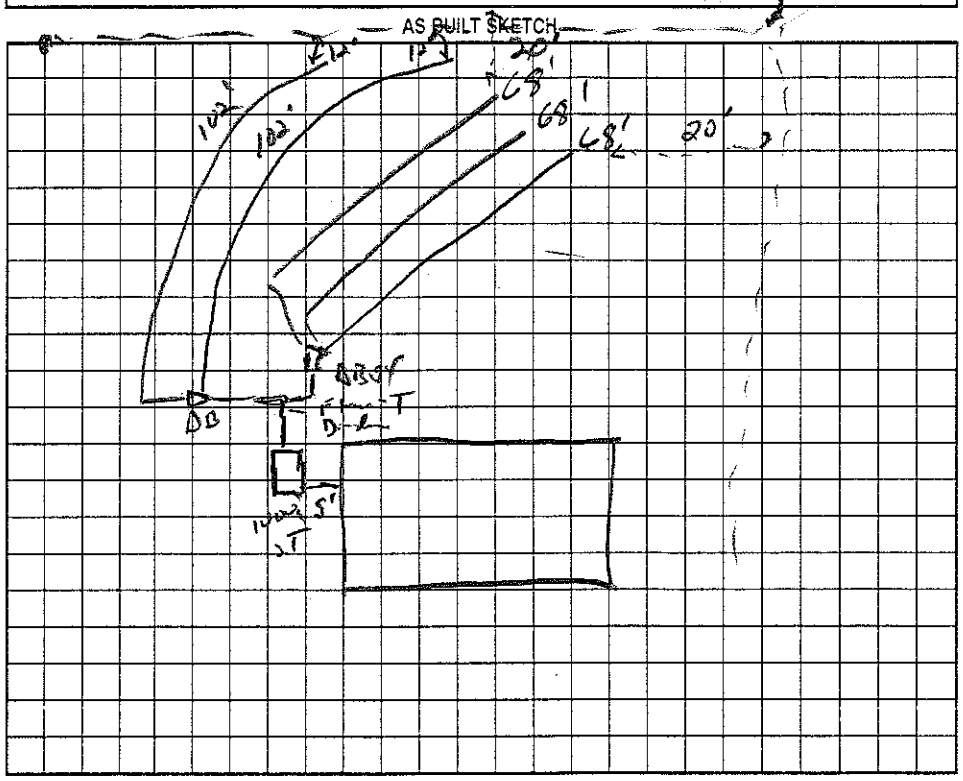

Permit can be suspended or revoked if any false information is supplied toward securing the permit/any unauthorized changes are made to the site/any unauthorized changes are made in the installation of the system. Improvement Permit with plat valid without expiration. Improvement Permit with site plan valid for sixty months. Authorization to Construct is valid for a period equal to that of Improvement Permit – not to exceed sixty months.

Signed: Roger S Morrison date 5-15-02

Improvement Permit by: William O. Johnson date 5/14/02

Authorization to Construct by: William O. Johnson date 5/14/02

Installed by: Abel Const.

Operation Permit by: Jim Tapp, R.S. date 16 Oct. 06

Existing System Inspection by: date

HEALTH DEPT. COPY: WHITE OWNER COPY (FINAL): YELLOW OWNER COPY (INITIAL): PINK