IREDELL COUNTY HEALTH DEPARTMENT

STATESVILLE 704-878-5305 MOORESVILLE 704-664-5281

IMPROVEMENT PERMIT / AUTHORIZATION TO CONSTRUCT / OPERATION PERMIT / EXISTING SYSTEM INSPECTION

PERMIT# 89505 PIN# DATE June 27, 2000

OWNER OR CONTRACTOR Silverwave Prop PHONE: Business 5326625 Home

ADDRESS 5551 Monroe Rd Charlotte

LOCATION Old MT Rd STH (R) Elewis Ferry on Left just before Eufola Rd Turn Left Lot on Right

SUBDIVISION Raefield BLOCK / SECTION LOT 9 LOT AREA 1.04 Ac SITE CLASS PS DESIGN FLOW 360 L.T.A.R. .3

Septic Tank: 1000 Gallons; STB 317 Date 9-30-00
Pump Tank: Gallons; PT Date
Pump Make: Model Serial No.
Nitrification Field: No Fields 1 Square Feet 1200 Linear Feet 300 ALT
No Lines 4 Trench Width 36" Max Trench Bottom Depth 36"

☒ New System ☐ Repair System Type: I, II, III, IV, V, VI
System Description: GRAVITY 25% Reduction
Repair System Description: SAME
Maintenance Agreement Required: ☐ Yes ☒ No
Gravel Depth N/A ☐ Slab ☒ Crawl Space ☐ Basement w/plumbing ☐ Basement wo/plumbing


☐ House/Mod. Home No. Bedrooms 3
☒ Mobile Home&W No. Bathrooms 2
☐ Business No. Employees
☐ Other

Water Supply: ☐ Individual ☒ Public ☐ Community


Comments/Conditions: INSTALL 50 Chambers OR 30 HDS Sections
MAY USE distribution box w/Speed levels
Remove field TERRACE. LOCATE home TO INSURE Septic
NOT TO SCALE

Comments/Conditions: Filter Installed - E-Z Flow installed
TANK SET BACKS From home & Prop. Lines

INITIAL SITE SKETCH

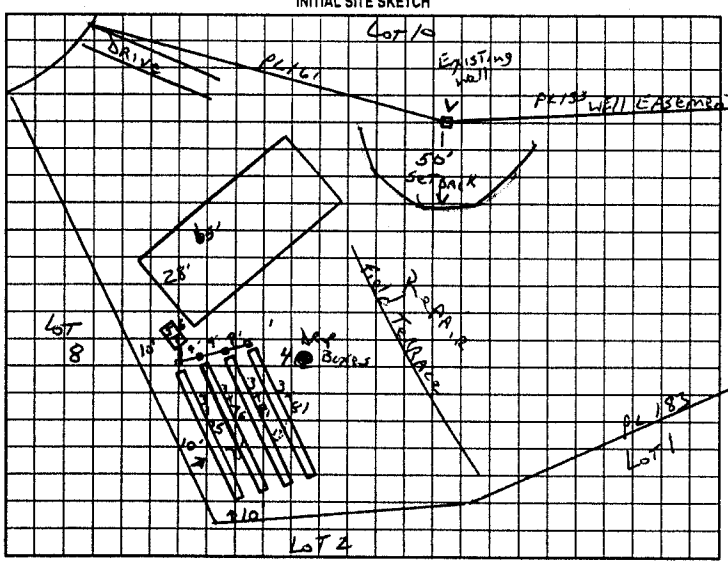

AS BUILT SKETCH

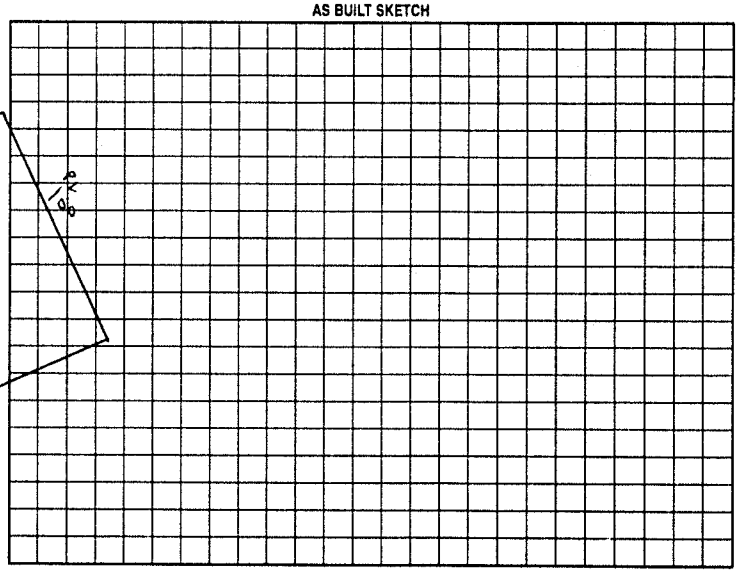

Permit can be suspended or revoked if any false information is supplied toward securing the permit/any unauthorized changes are made to the site/any unauthorized changes are made in the installation of the system. Improvement Permit with plat valid without expiration. Improvement Permit with site plan valid for sixty months. Authorization to Construct is valid for a period equal to that of Improvement Permit – not to exceed sixty months.

Signed: T Shane Boland date

Improvement Permit by: JC Potter date June 27, 2000

Authorization to Construct by: JC Potter date June 27, 2000

Installed by: Dellinger Grading

Operation Permit by: RST date 12/6/00

Existing System Inspection by: date

HEALTH DEPT. COPY: WHITE OWNER COPY (FINAL): YELLOW OWNER COPY (INITIAL): PINK