IREDELL COUNTY HEALTH DEPARTMENT

STATESVILLE 704-878-5305 MOORESVILLE 704-664-5281

IMPROVEMENT PERMIT / AUTHORIZATION TO CONSTRUCT / OPERATION PERMIT / EXISTING SYSTEM INSPECTION

PERMIT# 089506 PIN# 4702 68 3390 (PT) DATE 8-15-00

OWNER OR CONTRACTOR SILVERWAVE PROP. PHONE: Business (704) 532-66625 Home

ADDRESS 5551 MONROE ROAD CHARLOTTE, NC 28212

LOCATION OLD MOUNTAIN ROAD TO LEWIS FERRY ROAD, TL RAEFIELD DRIVE, 4TH LOT ON LEFT

SUBDIVISION RAEFIELD BLOCK / SECTION LOT 11 LOT AREA 0.74 ACRES SITE CLASS PS DESIGN FLOW 360 L.T.A.R. 0.30 SQ FT

Septic Tank: 1000 Gallons; STB 312 Date 6-27-00

Pump Tank: Gallons; PT Date

Pump Make: Model Serial No.

Nitrification Field: No Fields 1 Square Feet 1200 Linear Feet 400

No Lines FOUR Trench Width 36" Max Trench Bottom Depth 36" Gravel Depth 12"

☑ New System ☐ Repair System Type: I II III IV V VI

System Description: CONVENTIONAL GRAVITY

Repair System Description: CONVENTIONAL GRAVITY

Maintenance Agreement Required: ☐ Yes ☑ No

☐ House/Mod. Home No. Bedrooms 3

☐ Mobile Home No. Bathrooms 2

☐ Business No. Employees

☐ Other

☐ Slab ☐ Crawl Space ☐ Basement w/plumbing ☐ Basement wo/plumbing


Water Supply: ☐ Individual ☑ Public ☐ Community

Comments/Conditions: PROPERTY LINE 283.60'

100% REPAIR AREA


Comments/Conditions: SEPTIC TANK WITH MARKER INSTALLED USING "BABE" FILTER

INITIAL SITE SKETCH

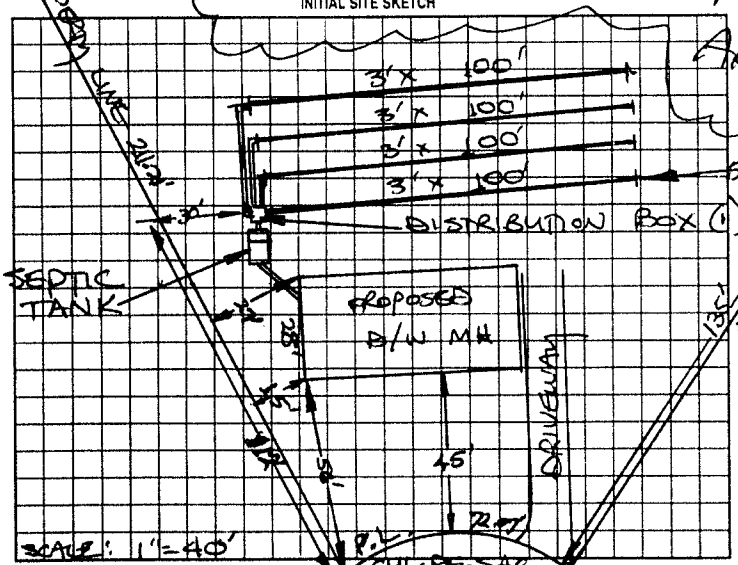

SCALE: 1"=40'

AS BUILT SKETCH

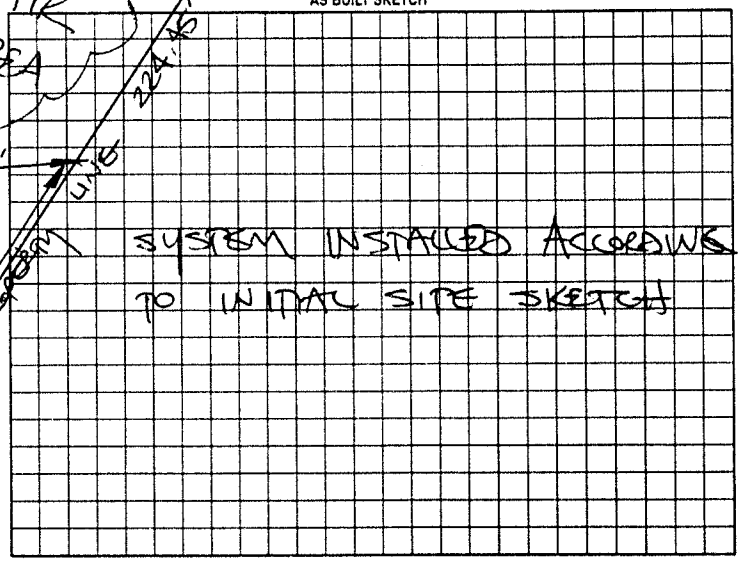

Permit can be suspended or revoked if any false information is supplied toward securing the permit/any unauthorized changes are made to the site/any unauthorized changes are made in the installation of the system. Improvement Permit with plat valid without expiration. Improvement Permit with site plan valid for sixty months. Authorization to Construct is valid for a period equal to that of Improvement Permit – not to exceed sixty months.

Signed: James J. Bartlin date 8-15-00 Installed by: KEN DELLINGER

Improvement Permit by: STEVE HEDRICK date 8-15-00 Operation Permit by: STEVE HEDRICK date 8-23-00

Authorization to Construct by: STEVE HEDRICK date 8-15-00 Existing System Inspection by: date

HEALTH DEPT. COPY: WHITE OWNER COPY (FINAL): YELLOW OWNER COPY (INITIAL): PINK