# IREDELL COUNTY HEALTH DEPARTMENT

STATESVILLE 704-878-5305 MOORESVILLE 704-664-5281

## IMPROVEMENT PERMIT / AUTHORIZATION TO CONSTRUCT / OPERATION PERMIT / EXISTING SYSTEM INSPECTION

PERMIT# 9001D PIN# 4702-68-3390 DATE 6-26-00

OWNER OR CONTRACTOR Silver Wave Properties PHONE: Business 7045326623 Home

ADDRESS 5551 Monroe Rd Charlotte N.C.

LOCATION I-40 W TL Old mnt. Rd TR Lewis Ferry TL Raefield 1st at end

SUBDIVISION Raefield BLOCK / SECTION LOT 10 LOT AREA 1.04 acres SITE CLASS. RS DESIGN FLOW 600 L.T.A.R. 1.3 gal/sq ft/day

Septic Tank: 1500 Gallons; STB 1011 Date 1/28/00

Pump Tank: Gallons; PT Date

Pump Make: Model Serial No.

Nitrification Field: No Fields 1 Square Feet 1500 Linear Feet 500

No Lines 5 Trench Width 36" Max Trench Bottom Depth 36" Gravel Depth N/A

☐ New System ☐ Repair System Type: I, II, III, IV, V, VI

System Description: Gravity 25% Reduction

Repair System Description: " 50% Reduction

Maintenance Agreement Required: ☐ Yes ☐ No

☐ Slab ☐ Crawl Space ☐ Basement w/plumbing ☐ Basement wo/plumbing

☐ House/Mod. Home No. Bedrooms 5

☐ Mobile Home No. Bathrooms 3

☐ Business No. Employees


☐ Other

Water Supply: ☐ Individual ☐ Public ☐ Community


Comments:/Conditions:

Comments:/Conditions:

INITIAL SITE SKETCH

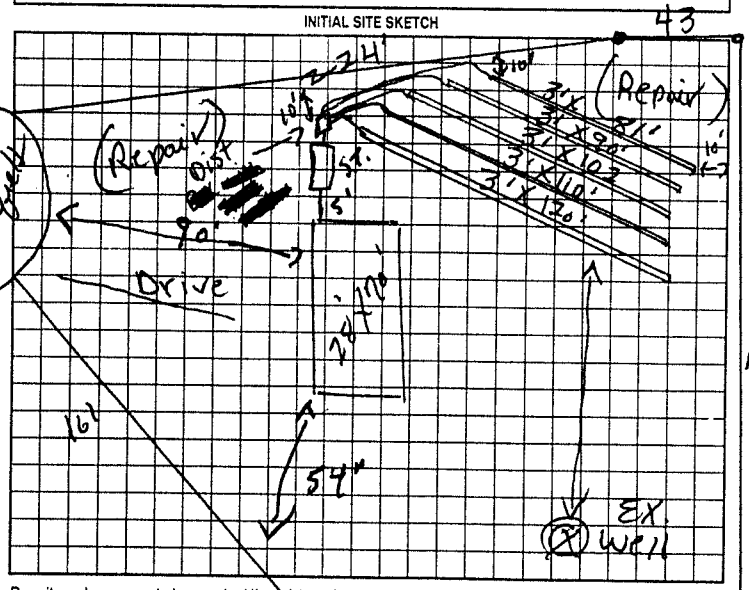


AS BUILT SKETCH

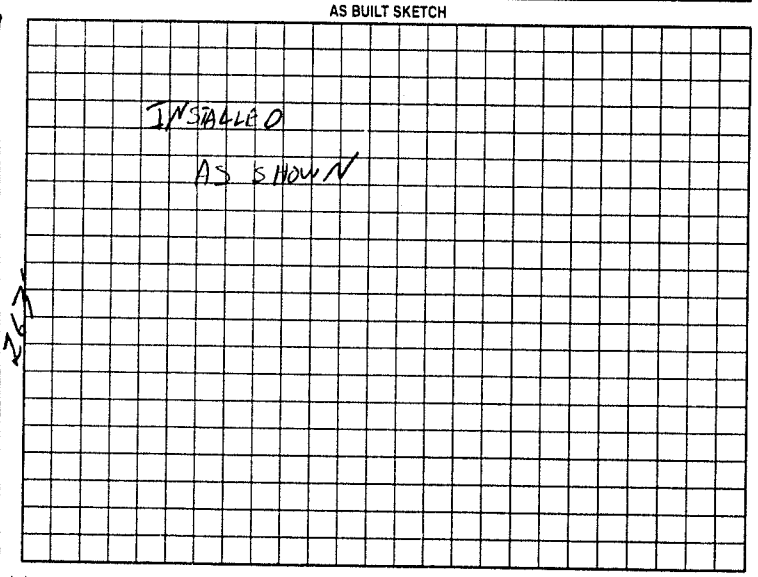


Permit can be suspended or revoked if any false information is supplied toward securing the permit/any unauthorized changes are made to the site/any unauthorized changes are made in the installation of the system. Improvement Permit with plat valid without expiration. Improvement Permit with site plan valid for sixty months. Authorization to Construct is valid for a period equal to that of Improvement Permit -- not to exceed sixty months.

Signed: date 7-10-00

Improvement Permit by: C.C. Moore date 6-26-00

Authorization to Construct by: C.C. Moore date 6-26-00

Installed by: A-1 Backhoe

Operation Permit by: C. Bly Ferguson RS date 7/11/00

Existing System Inspection by: date

HEALTH DEPT. COPY: WHITE OWNER COPY (FINAL): YELLOW OWNER COPY (INITIAL): PINK