52610

IREDELL COUNTY HEALTH DEPARTMENT

STATESVILLE 704-878-5305 MOORESVILLE 704-664-5281

IMPROVEMENT PERMIT / CERTIFICATE OF COMPLETION / OPERATION PERMIT / EXISTING SYSTEM INSPECTION

PROPERTY DESCRIPTION NO. 18560 DATE 6-27-94 TAX MAP NO. 8J-1-B-5 Watershed: ☐ Yes ☑ No

OWNER OR CONTRACTOR Bill Coley PHONE: Business _____ Home 528-4480

ADDRESS Rt. 2, Box 135 Troutman, N.C. 28166

LOCATION I40W TL old Mtn. Rd. TR Lewis Ferry Rd 2nd lot on L past Lamb Rd.

SUBDIVISION SJ Stewart Est. BLOCK / SECTION — LOT 5 LOT AREA 3.951 acres SITE CLASS. P.S. DESIGN FLOW 360 L.T.A.R. 3 ged Hfz

Septic Tank: 1000 Gallons; STB 794 Date 7-5-94

Pump Tank: — Gallons; PT — Date —

Pump Make: — Model — Serial No. —

Nitrification Field: No Fields 1 Square Feet 1200 Linear Feet 400'

No Lines 3 Trench Width 36" Max Trench Bottom Depth 30" Gravel Depth 12"

☑ New System ☐ Repair System Type: I, II, III, IV, V, VI

System Description: conventional, gravity fed

Repair System Description: " "

Maintenance Agreement Required: ☐ Yes ☑ No

☐ House/Mod. Home ☑ Mobile Home ☐ Business ☐ Other

No. Bedrooms 3 No. Bathrooms 2 No. Employees —


☐ Slab ☑ Crawl Space ☐ Basement w/plumbing ☐ Basement wo/plumbing

Water Supply: ☑ Individual ☐ Community ☐ Public


Comments: INSTALL SYSTEM SHALLOW! (no deeper than 30" to trench bottom) Keep Lines and Trenches on contour. Keep system min. 5' from foundation of home, 10' from all property lines, and keep well 50' from septic system and Repair Areas. Repair Area located, 50% below system, 50% behind home. Create surface diversion above driveway and cut area down at center of lot to allow proper drainage. * Do not cut or fill in area where drainfield is to be installed (1' of fill allowed.)

Comments: System checked 8-29-94. Surface diversion ditch and high area at Rd cut 9-19-94. Soil had relic mottling, may require interceptor drain if surface diversions does not correct [redacted] water drainage. Well located at time of inspection, it is 50' from any part of system.

INITIAL SITE SKETCH

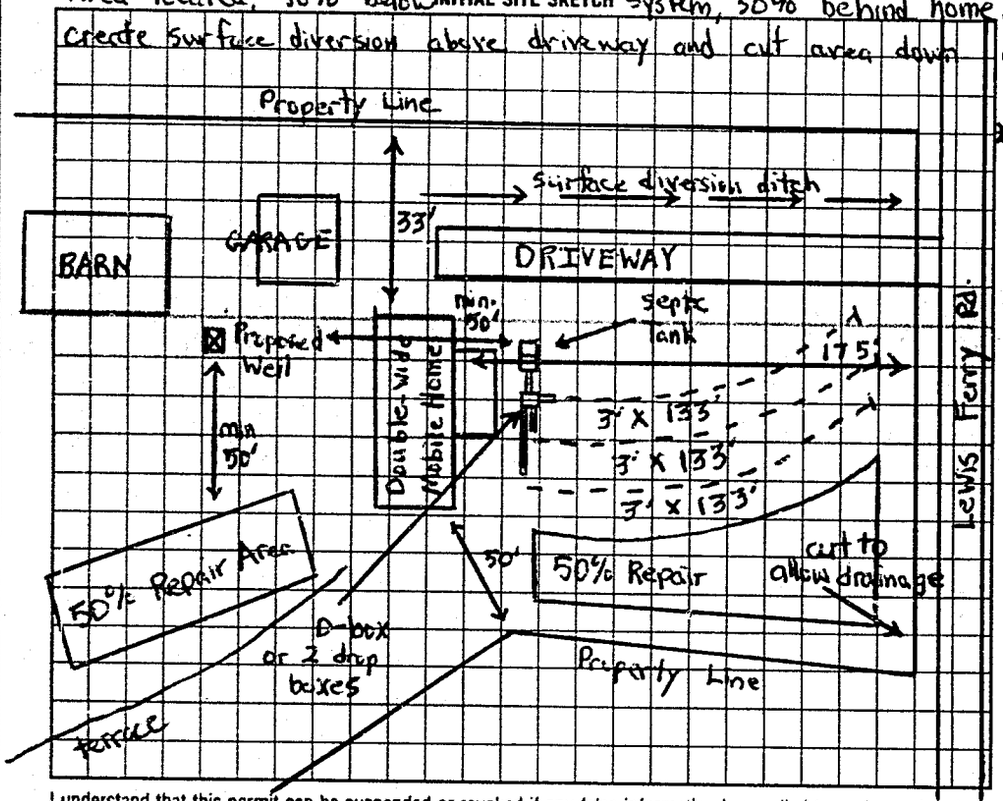

AS BUILT SKETCH

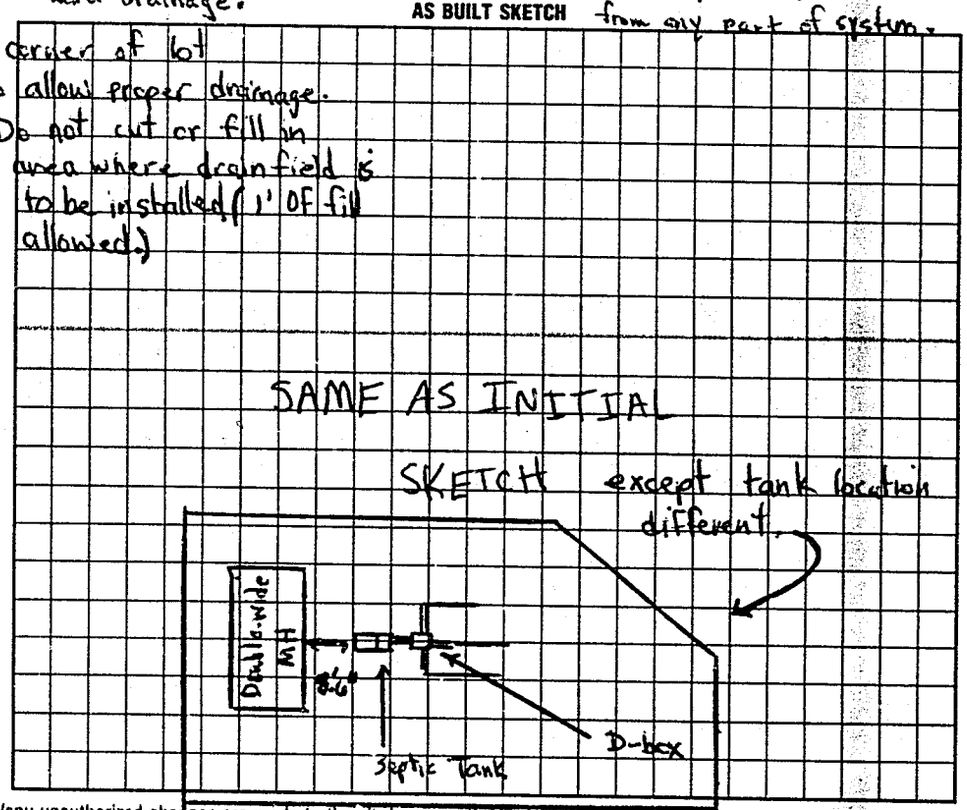

I understand that this permit can be suspended or revoked if any false information is supplied toward securing the permit/any unauthorized changes are made to the site/any unauthorized changes are made in the installation of the system. Improvement Permit is valid for 60 months from date of issuance.

Signed: X Billy Eg. Coley

Improvement Permit by: Michael J. Deaver date 6-27-94.

Existing System Inspection by: _____ date _____

Installed by: A-1 Backhoe

Certificate of Completion by: Michael J. Deaver date 9-19-94

Operation Permit by: _____ date _____

HEALTH DEPT. COPY: WHITE INSPECTION COPY (FINAL): GREEN OWNER COPY (FINAL): YELLOW INSPECTION COPY (INITIAL): PINK OWNER COPY (INITIAL): GOLD

8 6 7 0 0 0