IREDELL COUNTY HEALTH DEPARTMENT

STATESVILLE 704-878-5305 MOORESVILLE 704-664-5281

IMPROVEMENT PERMIT / AUTHORIZATION TO CONSTRUCT / OPERATION PERMIT / EXISTING SYSTEM INSPECTION

PERMIT# Repair PIN# 4702-67-9223 DATE 2/7/02

OWNER OR CONTRACTOR Mitchell + Ginger Riddick PHONE: Business — Home (704) 872-2446

ADDRESS 146 Lamb Road Statesville NC 28677

LOCATION I-40 W, (D) OMR, (R) Lewis Ferry Road, (L) Lamb Road

SUBDIVISION _____ BLOCK / SECTION _____ LOT 5 LOT AREA _____ Acres SITE CLASS PS DESIGN FLOW 360 L.T.A.R. .3

Septic Tank: Existing (Used) Gallons: STB _____ Date _____

Pump Tank: _____ Gallons: PT _____ Date _____

Pump Make: _____ Model _____ Serial No _____

Nitrification Field: No Fields 1 Square Feet 910 Linear Feet +/- 270'

No Lines 4 Trench Width 36" Max Trench Bottom Depth 36" Gravel Depth 12"

☐ New System (X) Repair System Type: I (II) III IV V VI

System Description: _____

Repair System Description: Gravity Conventional

Maintenance Agreement Required: ☐ Yes X No

☐ House/Mod. Home ☒ Mobile Home ☐ Business ☐ Other

No. Bedrooms 3 No. Bathrooms 2 No. Employees _____


☐ Slab X Crawl Space ☐ Basement w/plumbing ☐ Basement wo/plumbing

Water Supply: ☐ Individual X Public ☐ Community

Comments/Conditions: ① Relocate [redacted] Public H2O 15' - (2) Repl 10ft off existing H2O Riser (3) Insul 4 Drop over (4) Replace 1 Jct. box if necessary [redacted] (263' PL) (5) Pump Tank

Comments/Conditions: Original Installation - Mike Soirce 8-18-86 (#04496) Installed 306 Ft of Gravity Conventional System before Repair

INITIAL SITE SKETCH

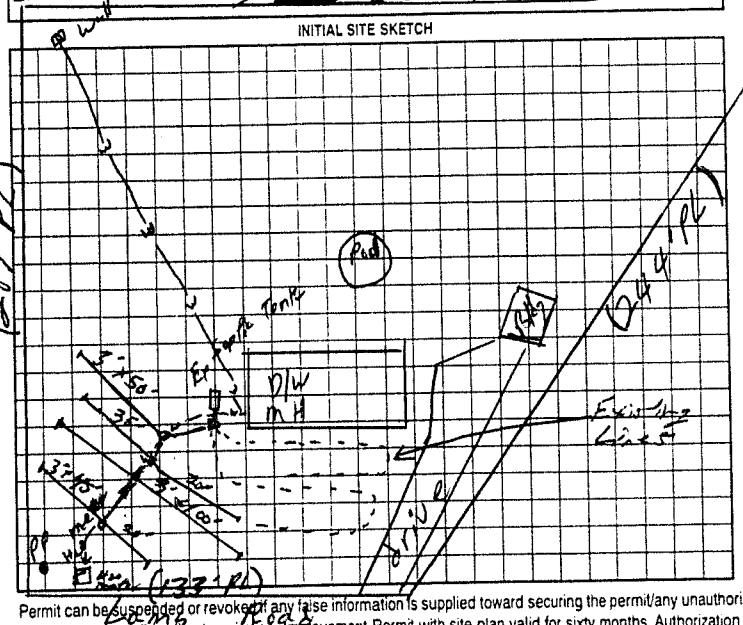

AS BUILT SKETCH

Relocated H2O Line.

Trench depth @ 48-50" because of depth of Existing Tank. Gravel depth 16".

Installed as Shown.

Permit can be suspended or revoked if any false information is supplied toward securing the permit/any unauthorized changes are made to the site/any unauthorized changes are made in the installation of the system. Improvement Permit with plat valid without expiration. Improvement Permit with site plan valid for sixty months. Authorization to Construct is valid for a period equal to that of Improvement Permit – not to exceed sixty months.

Signed: Mitchell Riddick date 2/7/02 Installed by: James Hudler

Improvement Permit by: William A Johnson date 2/7/02 Operation Permit by: William A Johnson date 2/14/02

Authorization to Construct by: William A Johnson date 2/7/02 Existing System Inspection by: _____ date _____

HEALTH DEPT. COPY: WHITE OWNER COPY (FINAL): YELLOW OWNER COPY (INITIAL): PINK