IREDELL COUNTY HEALTH DEPARTMENT

STATESVILLE 704-878-5305 MOORESVILLE 704-664-5281

IMPROVEMENT PERMIT / AUTHORIZATION TO CONSTRUCT / OPERATION PERMIT / EXISTING SYSTEM INSPECTION

PERMIT# 14489 PIN# 4702-69-3169 DATE 10 September-07

OWNER OR APPLICANT Lisa & Craig Christensen PHONE: Business Home 704-578-6435

ADDRESS 154 Isle of Pines Dr. Mooresville N.C. 28115

LOCATION Old NC 90 Rd. TL Lewis Farm Rd. 2 miles on Rt.

SUBDIVISION BLOCK / SECTION LOT 3B LOT AREA 3.09 Ac. SITE CLASS. P3 DESIGN FLOW 450 gpd L.T.A.R. 0.33/FT²/day

Septic Tank: 1000 Gallons: STB Date

Pump Tank: Gallons; PT Date

Pump Make: Model Serial No.

Nitrification Field: No Fields 1 Square Feet ≈ 1600 Linear Feet 480

No Lines 4 Trench Width 36" Max Trench Bottom Depth 30" Gravel Depth

☑ New System ☐ Repair ☐ Expansion System Type: I II III IV V VI

System Description: 25% Reduction w/ Infiltrator

Repair System Description: 25% Red.

Maintenance Agreement Required: ☐ Yes ☑ No

☑ Gravity ☐ Pressure ☐ Slab ☑ Crawl Space ☐ Basement w/plumbing ☐ Basement wo/plumbing

☑ House/Mod. Home No. Bedrooms 4

☐ Mobile Home No. Persons

☐ Business No. Employees

☐ Other

Water Supply: ☑ Individual ☐ Public ☐ Community

Comments:/Conditions:

Follow contour / Keep out of low area


Comments:/Conditions:

Fill - as installed.

INITIAL SITE SKETCH

Please see Attached Site plans

AS BUILT SKETCH

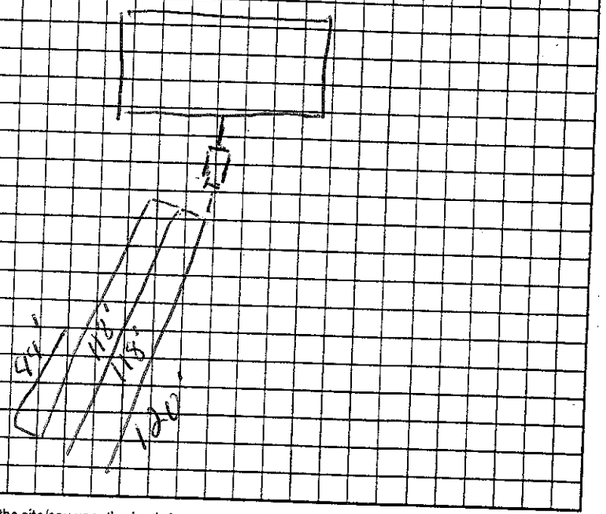

Permit can be suspended or revoked if any false information is supplied toward securing the permit/any unauthorized changes are made to the site/any unauthorized changes are made in the installation of the system. Improvement Permit with plat valid without expiration. ☐ Improvement Permit with site plan valid for sixty months ☑ Authorization to Construct is valid for a period equal to that of Improvement Permit – not to exceed sixty months.

Signed: date 9-21-07

Improvement Permit by: , R.S. date 10 Sept. 07


Authorization to Construct by: , R.S. date 10 Sept. 07

Installed by: Kevin Bowles

Operation Permit by: , R.S. date 1 Oct. 08

Existing System Inspection by: date

HEALTH DEPT. COPY: WHITE OWNER COPY (FINAL): YELLOW OWNER COPY (INITIAL): PINK

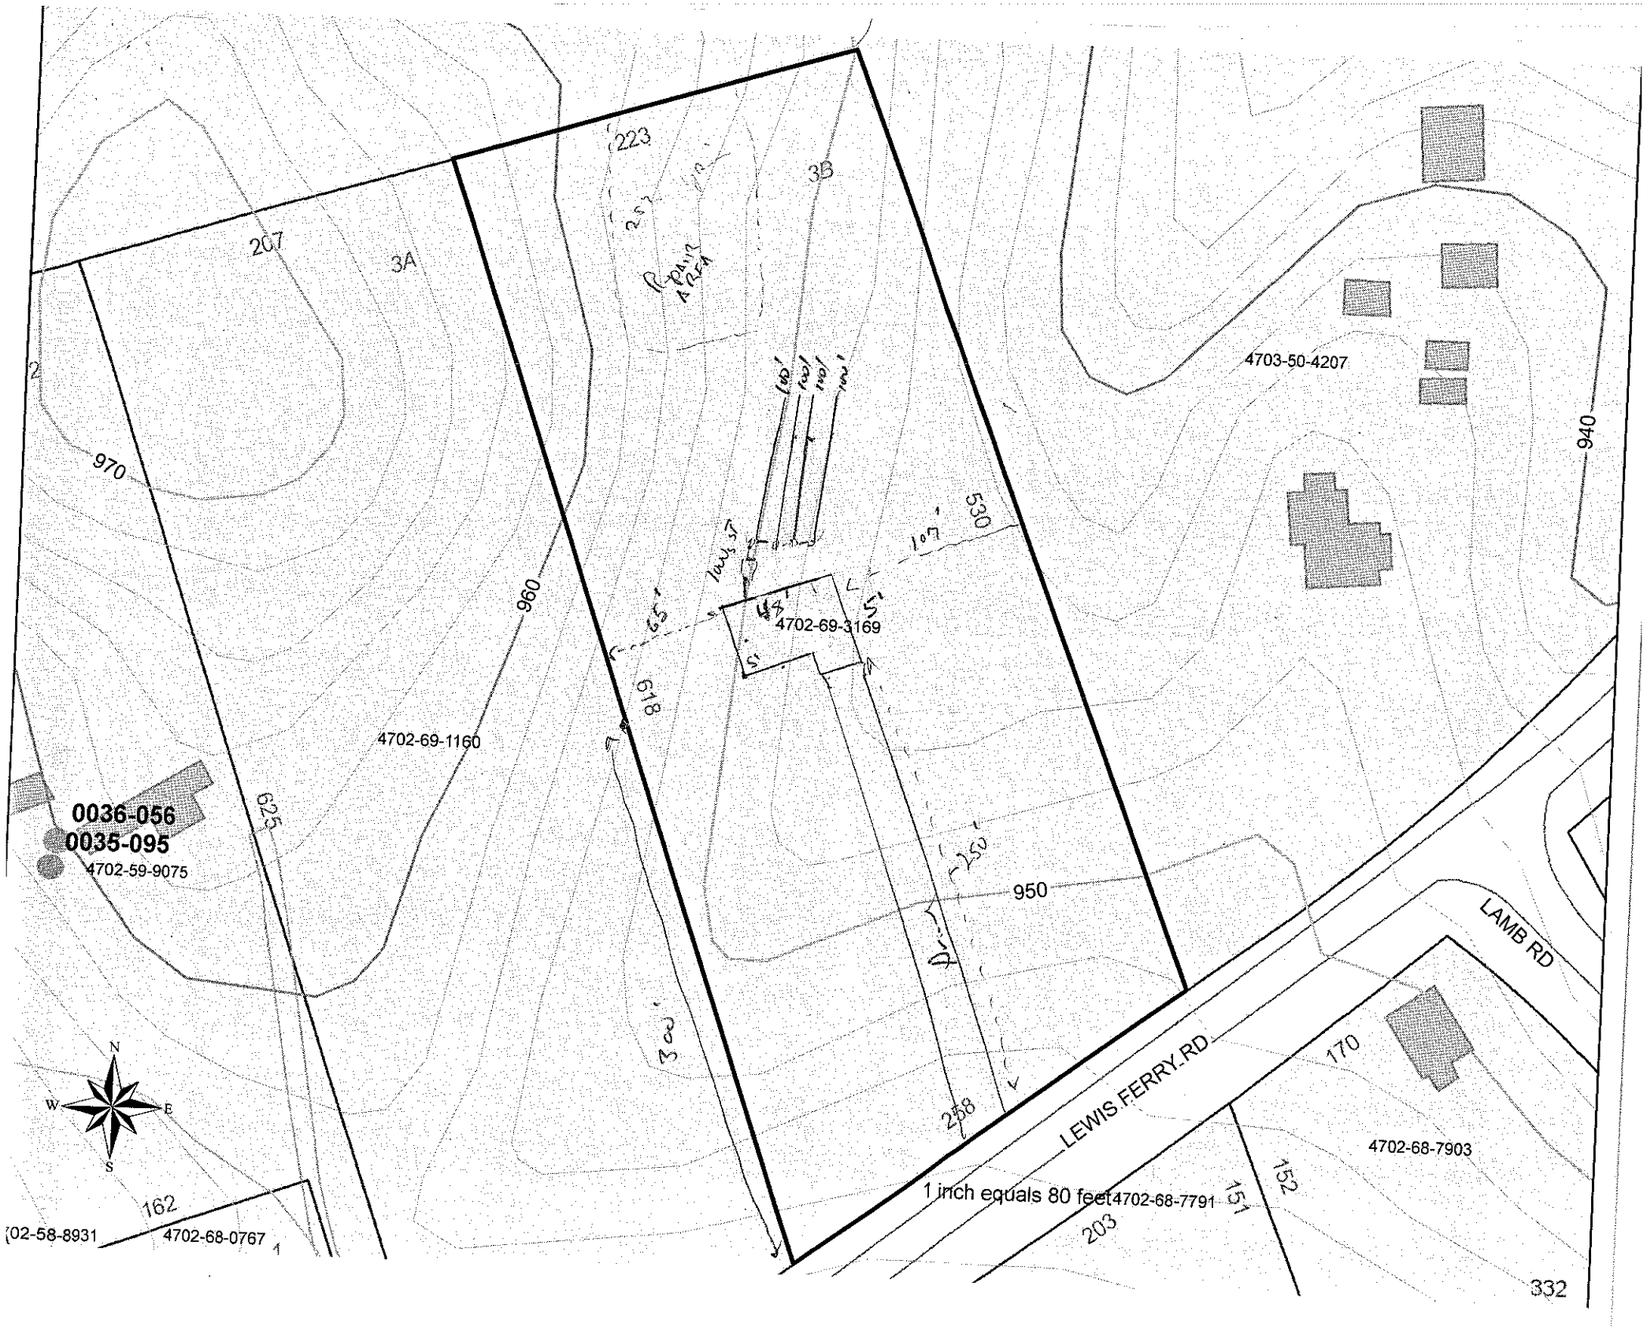
223
3B
207
3A
970
960
530
107
618
625
940
4703-50-4207
4702-69-3169
4702-69-1160
0036-056
0035-095
4702-59-9075
950
250
300
258
LAMB RD
LEWIS FERRY RD
170
4702-68-7903
4702-68-7791
151
152
203
332
162
4702-68-0767
N
W
E
S
1 inch equals 80 feet