# IREDELL COUNTY HEALTH DEPARTMENT

STATESVILLE 704-878-5305 MOORESVILLE 704-664-5281

## IMPROVEMENT PERMIT / AUTHORIZATION TO CONSTRUCT / OPERATION PERMIT / EXISTING SYSTEM INSPECTION

DATE Dec 17, 99

PERMIT# 86638 PIN# 4702739653

OWNER OR CONTRACTOR OAKwood Homes PHONE: Business 704 528 4516 Home

ADDRESS 1012 Charlotte Hwy TROUTMAN

LOCATION Old MT Rd 5th (R) E Lewis Ferry (R) Eufola (R) Barbary Lot 43 on Right

SUBDIVISION Lansdowne BLOCK / SECTION LOT 43 LOT AREA 1Ac SITE CLASS PS DESIGN FLOW 360 L.T.A.R. .3

Septic Tank: 1000 Gallons; STB 312 Date 5 3 99

Pump Tank: Gallons; PT Date

Pump Make: Model Serial No.

Nitrification Field: No Fields 1 Square Feet 1200 Linear Feet 400

No Lines 5 Trench Width 36" Max Trench Bottom Depth 24-36" Gravel Depth 12"

☒ New System ☐ Repair System Type: I, (II), III, IV, V, VI

System Description: Conv. Gravity

Repair System Description: Conv. Gravity/Pump 252 Gal

Maintenance Agreement Required: ☐ Yes ☒ No Pump Tank

☐ House/Mod. Home No. Bedrooms 3

☒ Mobile Home 3 Wide No. Bathrooms 2

☐ Business No. Employees

☐ Other


☐ Slab ☒ Crawl Space ☐ Basement w/plumbing ☐ Basement wo/plumbing

Water Supply: ☐ Individual ☒ Public ☐ Community


Comments/Conditions: Observe Setback Rules
Stay out of shallow soil area

Comments/Conditions:

INITIAL SITE SKETCH

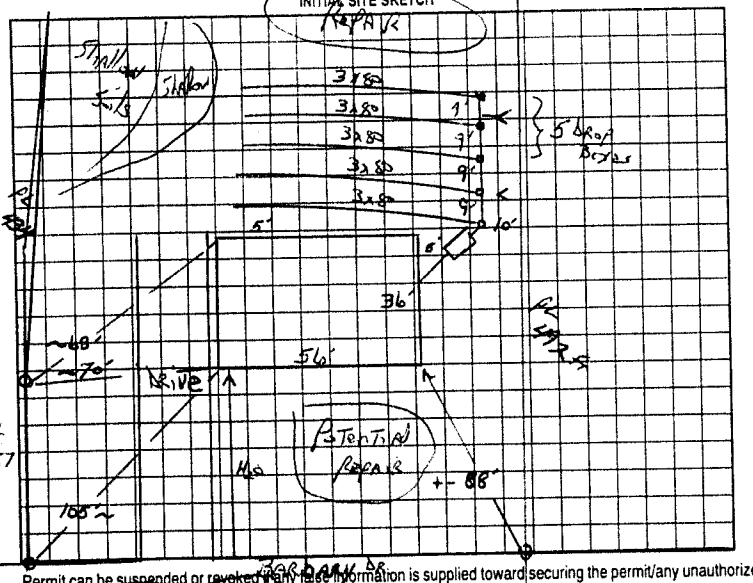


AS BUILT SKETCH

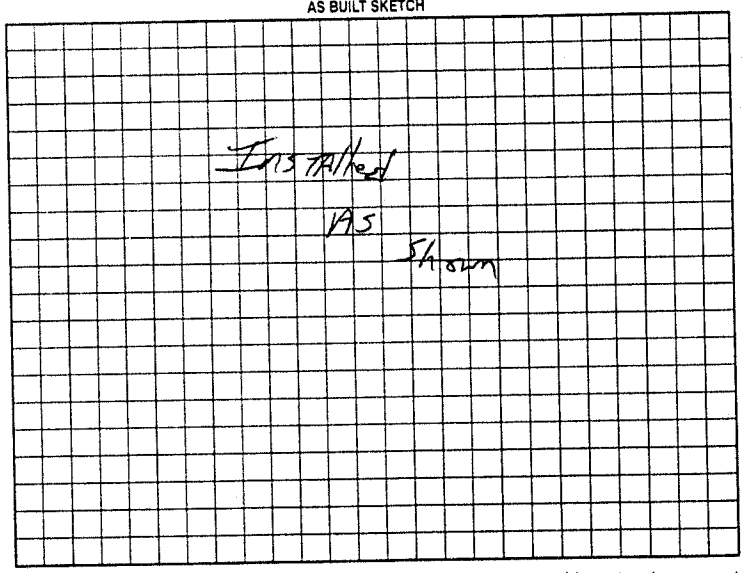


Permit can be suspended or revoked if any false information is supplied toward securing the permit/any unauthorized changes are made to the site/any unauthorized changes are made in the installation of the system. Improvement Permit with plat valid without expiration. Improvement Permit with site plan valid for sixty months. Authorization to Construct is valid for a period equal to that of Improvement Permit - not to exceed sixty months.

Signed: date 12-20-99

Improvement Permit by: L Potter date Dec 17 99

Authorization to Construct by: L Potter date Dec 17, 99

Installed by: Larry Tucker 2000

Operation Permit by: L Potter date Jan 5 00

Existing System Inspection by: date

HEALTH DEPT. COPY: WHITE OWNER COPY (FINAL): YELLOW OWNER COPY (INITIAL): PINK