IREDELL COUNTY HEALTH DEPARTMENT

STATESVILLE 704-878-5305 MOORESVILLE 704-664-5281

IMPROVEMENT PERMIT / AUTHORIZATION TO CONSTRUCT / OPERATION PERMIT / EXISTING SYSTEM INSPECTION

PERMIT# 78976 PIN# 4702 73 9709 DATE 3-3-99

OWNER OR CONTRACTOR Stephen Falzone PHONE: Business 664 6735 Home

ADDRESS PO Box 3093 Mooresville N.C.

LOCATION Enfola Rd 1st Barbour Dr lot on left

SUBDIVISION Landsdowne BLOCK / SECTION LOT 44 LOT AREA 1.83 acres SITE CLASS. PS DESIGN FLOW 360 L.T.A.R. 1.3

Septic Tank: 1000 Gallons; STB 1012 Date 12/09/99
Pump Tank: Gallons; PT Date
Pump Make: Model Serial No.
Nitrification Field: No Fields 1 Square Feet 1200 Linear Feet 460
No Lines 3 Trench Width 36" Max Trench Bottom Depth 36" Gravel Depth 12"

☑ New System ☐ Repair System Type: I, II, III, IV, V, VI
System Description: Conv. Gravity
Repair System Description:
Maintenance Agreement Required: ☐ Yes ☑ No

☑ House/Mod. Home ☐ Mobile Home ☐ Business ☐ Other
No. Bedrooms 3 No. Bathrooms 2 No. Employees


Water Supply: ☐ Individual ☑ Public ☐ Community

☐ Slab ☑ Crawl Space ☐ Basement w/plumbing ☐ Basement wo/plumbing


Comments/Conditions:

Comments/Conditions: 3.15.2000 Top 2 Lines inspected - OK
Line 1 - 145 ft. 3.16.2000 LAST Line Installed
2 - 145 ft
3

INITIAL SITE SKETCH

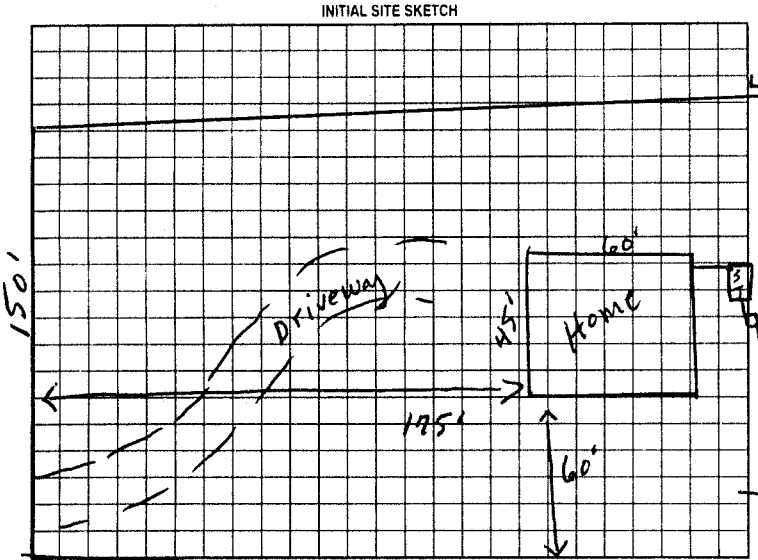

AS BUILT SKETCH

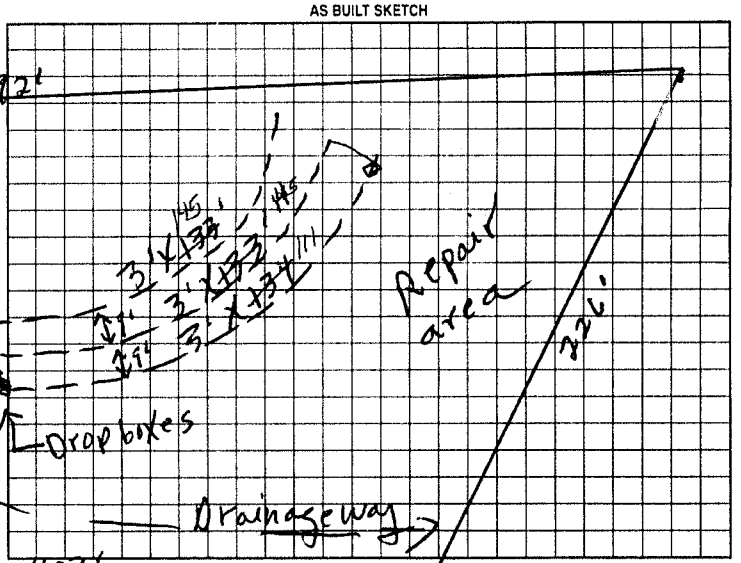

Permit can be suspended or revoked if any false information is supplied toward securing the permit/any unauthorized changes are made to the site/any unauthorized changes are made in the installation of the system. Improvement Permit with plat valid without expiration. Improvement Permit with site plan valid for sixty months. Authorization to Construct is valid for a period equal to that of Improvement Permit – not to exceed sixty months.

Signed: X Stephen Falzone date 2-3-99 Installed by: Al Backhoe

Improvement Permit by: F. C. Moore date 3-3-99 Operation Permit by: Potter date March 16 2000

Authorization to Construct by: F. C. Moore date 3-3-99 Existing System Inspection by: date

HEALTH DEPT. COPY WHITE OWNER COPY (FINAL) YELLOW OWNER COPY (INITIAL) PINK