IREDELL COUNTY HEALTH DEPARTMENT

STATESVILLE 704-878-5305 MOORESVILLE 704-664-5281

IMPROVEMENT PERMIT / AUTHORIZATION TO CONSTRUCT / OPERATION PERMIT / EXISTING SYSTEM INSPECTION

PERMIT# 87536 PIN# 4702748158 DATE Feb 9 2000

OWNER OR CONTRACTOR Kings Forest PHONE: Business 532 6525 Home

ADDRESS 5551 Monroe Rd Charlotte

LOCATION Old Mt Rd St (R) Elevis Ferry (L) Eufola (R) Barbary Lot is on Right

SUBDIVISION Lansdowne BLOCK / SECTION LOT 46 LOT AREA 1.53 SITE CLASS. 25 DESIGN FLOW 360 L.T.A.R. .33

Septic Tank: 1000 Gallons: STB 1012 Date 11 10 99
Pump Tank: Gallons: PT Date
Pump Make: Model Serial No.
Nitrification Field: No Fields Square Feet Linear Feet
No Lines 5 Trench Width 36" Max Trench Bottom Depth 36 Gravel Depth 12"

☒ New System ☐ Repair System Type: I. II. III. IV. V. VI
System Description: Conv. Gravity
Repair System Description: Same
Maintenance Agreement Required: ☐ Yes ☒ No

☒ House/Mod. Home No. Bedrooms 3
☐ Mobile Home No. Bathrooms 2
☐ Business No. Employees
☐ Other


☐ Slab ☒ Crawl Space ☐ Basement w/plumbing ☐ Basement wo/plumbing

Water Supply: ☐ Individual ☒ Public ☐ Community


Comments/Conditions: Obey All Setback Rules PL 330

Comments/Conditions:

INITIAL SITE SKETCH

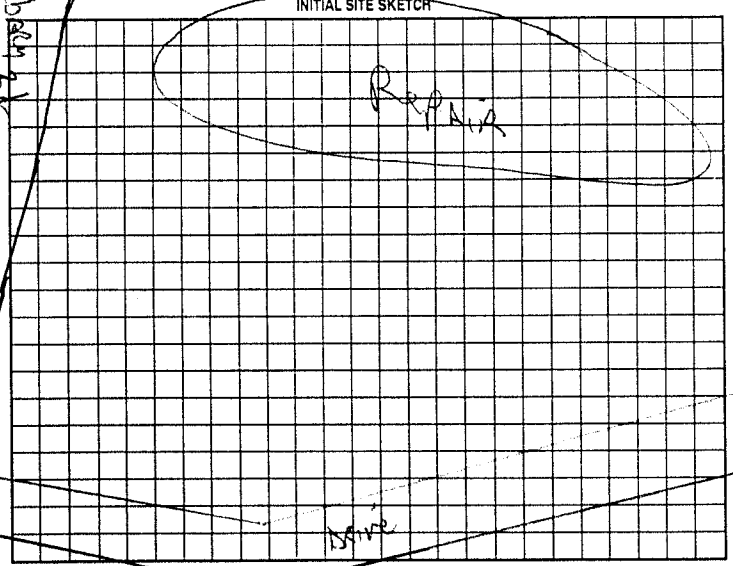

AS BUILT SKETCH

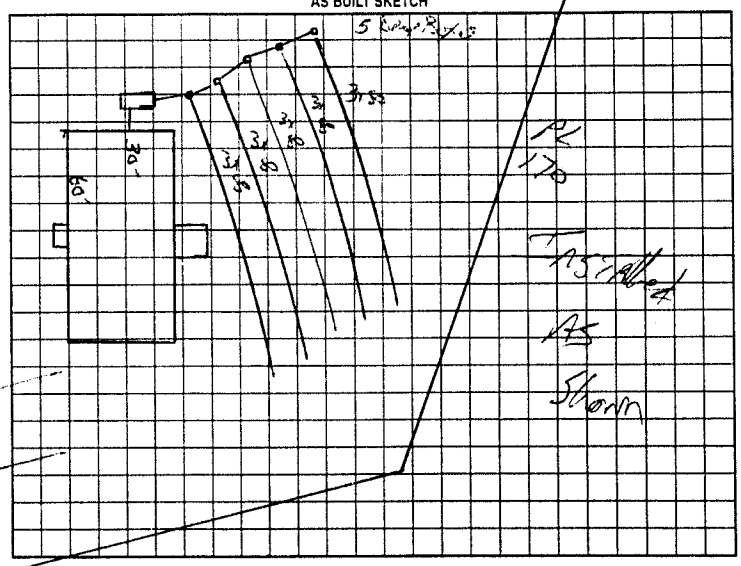

Permit can be suspended or revoked if any false information is supplied toward securing the permit/any unauthorized changes are made to the site/any unauthorized changes are made in the installation of the system. Improvement Permit with plat valid without expiration. Improvement Permit with site plan valid for sixty months. Authorization to Construct is valid for a period equal to that of Improvement Permit – not to exceed sixty months.

Signed: Shawn Bulgin date 2/9/2000 Installed by: Kenny Madison

Improvement Permit by: C Potter date Feb 9 2000 Operation Permit by: C Potter date March 7 2000

Authorization to Construct by: C Potter date Feb 9 2000 Existing System Inspection by: date

HEALTH DEPT. COPY: WHITE OWNER COPY (FINAL): YELLOW OWNER COPY (INITIAL): PINK