11:30

IREDELL COUNTY HEALTH DEPARTMENT - *ENVIRONMENTAL HEALTH* ☐ STATESVILLE OFFICE 704-878-5305 ☐ MOORESVILLE OFFICE 704-664-5281

IMPROVEMENT PERMIT / AUTHORIZATION TO CONSTRUCT / OPERATION PERMIT / EXISTING SYSTEM INSPECTION

PERMIT # 164459 PIN # 4702-74-8158 DATE JANUARY 24, 2011

OWNER GLORIA & NORMAN BATZ APPLICANT: PHONE: Home/Cell # Business # 704-746-4597

SITE ADDRESS 202 BARBARY DRIVE OWNER / APPLICANT ADDRESS

SITE DIRECTIONS EUFOLA ROAD TO BARBARY DRIVE, IT'S LOT ON RIGHT AT BOX # 202

SUBDIVISION LANSDOWN BLOCK / SECTION LOT # 46 LOT AREA 1.58 ACRES DESIGN FLOW 360 L.T.A.R. 0.30 GPD/FT²

Septic Tank EXISTING Gallons: STB Date

Pump Tank Gallons: P T Date

Pump Make Model Serial #

No. Nitrification Fields: 1 No. Lines 2 Linear Feet 120

Trench Width 36" Max. Trench Bottom Depth 30" Gravel Depth N/A

☑ New System ☐ Repair ☐ Expansion System Type I II III IV V VI

System Description: 25% REDUCTION, GRAVITY

Repair System Description: CONVENTIONAL, PUMP

Maintenance Agreement Required ☐ YES ☑ NO

☑ GRAVITY ☐ PRESSURE

☑ Residence No. Bedrooms 3

☐ Business No. Persons

☐ Other No. Employees


☐ Slab ☑ Crawl Space

☐ Basement w/plumbing ☐ Basement w/o plumbing

Water Supply: ☐ Private ☑ Public ☐ Community

Comments / Conditions ① CONNECT SEPTIC TANK TO THIRD DRAINLINE USING 3'x~20', BYPASSING 1ST TWO DRAIN LINES; ② INSTALL TWO (2) NEW DRAINLINES USING 25% REDUCTION AS SHOWN, NO DEEPER THAN 30".

INITIAL SITE SKETCH

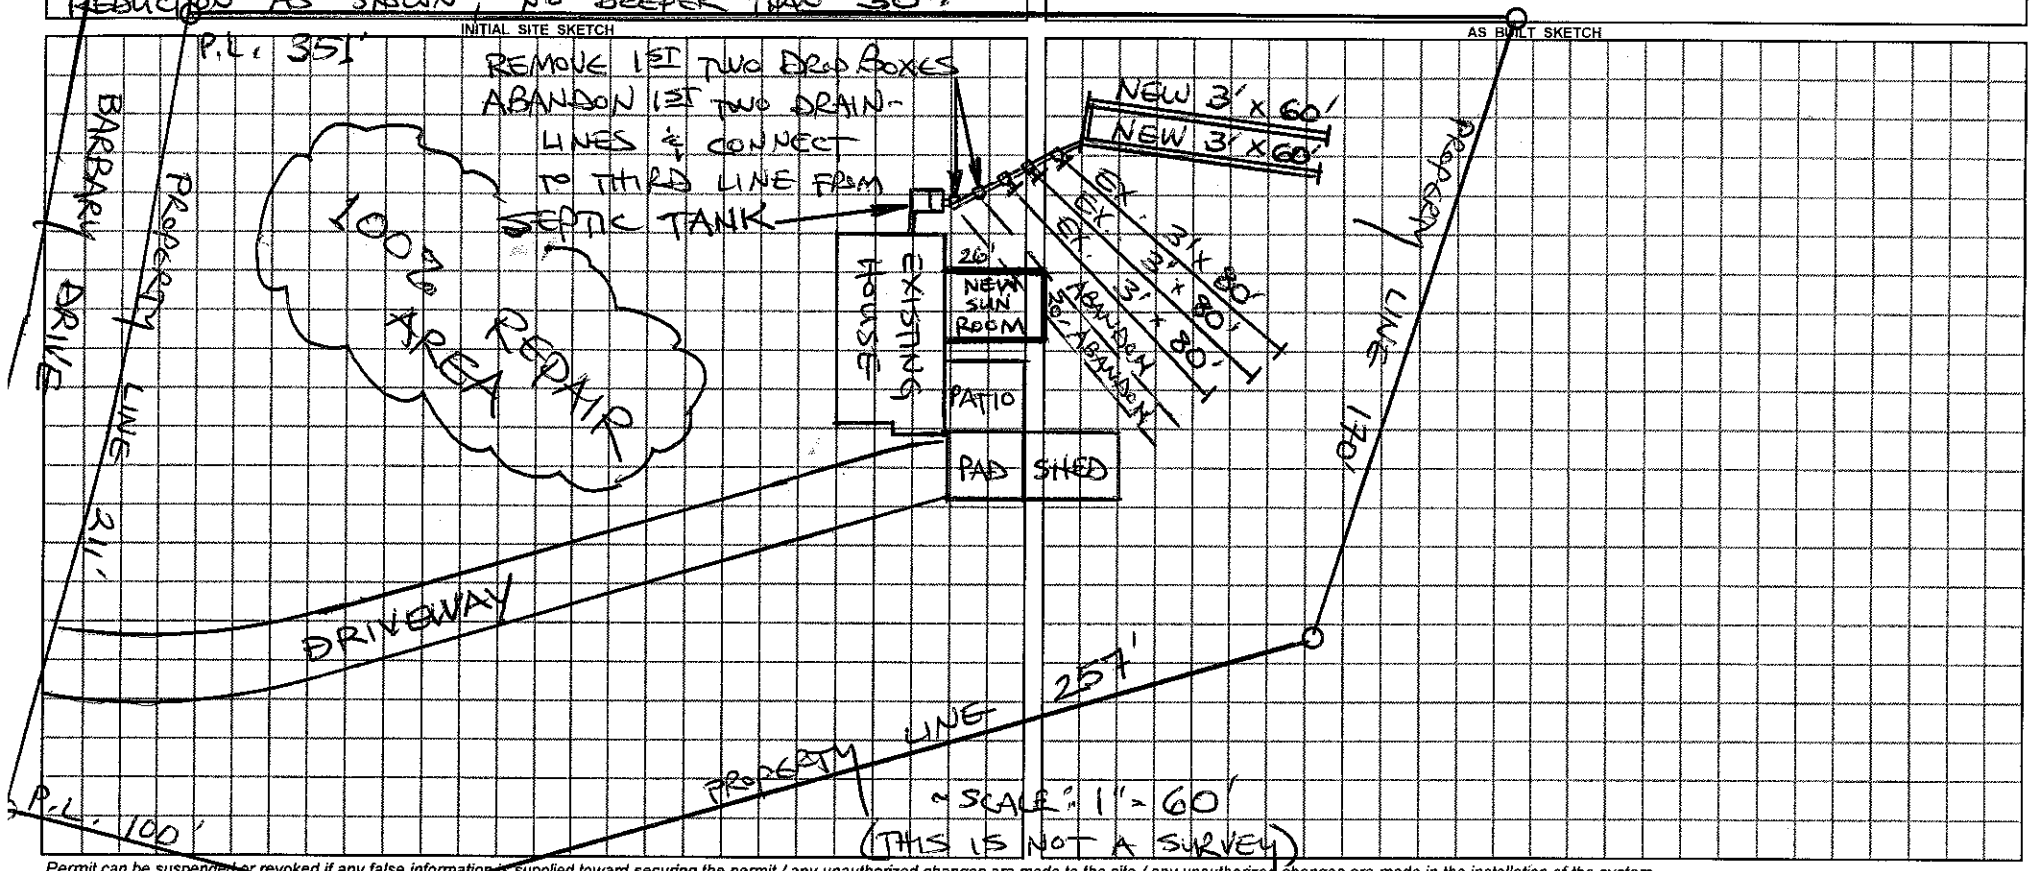

AS BUILT SKETCH

Permit can be suspended or revoked if any false information is supplied toward securing the permit / any unauthorized changes are made to the site / any unauthorized changes are made in the installation of the system.

☐ ***IMPROVEMENT PERMIT*** with plat valid without expiration. ☐ ***IMPROVEMENT PERMIT*** with plat valid ~~without expiration~~ 60 MOS / ☐ ***AUTHORIZATION TO CONSTRUCT*** valid for period equal to IMPROVEMENT PERMIT--not to exceed 60 mo.

Owner / Applicant Signature: Steve Kolin Date 1-26-11 Installed by: Abee Grading

IMPROVEMENT PERMIT by: STEVE HEDRICK REHS Date 1-24-11 OPERATION PERMIT by: REHS Date 2-2-11

AUTHORIZATION TO CONSTRUCT by: STEVE HEDRICK REHS Date 1-24-11 Existing System Inspected by: REHS Date

YOU SHOULD CONTACT A LOCATOR SERVICE PRIOR TO ANY EXCAVATION

White Copy – Environmental Health YELLOW COPY (Final) Owner / Applicant PINK COPY (Initial) Owner / Applicant