IREDELL COUNTY HEALTH DEPARTMENT

STATESVILLE 704-878-5305 MOORESVILLE 704-664-5281

IMPROVEMENT PERMIT / AUTHORIZATION TO CONSTRUCT / OPERATION PERMIT / EXISTING SYSTEM INSPECTION

PERMIT# 79582 PIN# 4702 748452 DATE 3 23 99

OWNER OR CONTRACTOR DAWN WALLACE PHONE: Business 704 630 9266 Home

ADDRESS 3835 Statesville Blvd Salisbury, NC

LOCATION Lot 47 Landsdowne & Eufola Rd

SUBDIVISION Landsdowne BLOCK / SECTION LOT 47 LOT AREA 2.54 Ac SITE CLASS PS DESIGN FLOW 360 L.T.A.R. .3

Septic Tank: 1000 Gallons; STB 1012 Date 2-19-99
Pump Tank: Gallons; PT Date
Pump Make: Model Serial No.
Nitrification Field: No Fields 1 Square Feet 4400 Linear Feet 400
No Lines 4 Trench Width 36" Max Trench Bottom Depth 56" Gravel Depth 12"

☒ New System ☐ Repair System Type: (I) II, III, IV, V, VI
System Description: Gravity Conv.
Repair System Description: Gravity/Pump Conv.
Maintenance Agreement Required: ☐ Yes ☒ No

☐ House/Mod. Home ☒ Mobile Home ☐ Business ☐ Other
No. Bedrooms 3 No. Bathrooms 2 No. Employees


☐ Slab ☒ Crawl Space ☐ Basement w/plumbing ☐ Basement wo/plumbing

Water Supply: ☐ Individual ☒ Public ☐ Community


Comments/Conditions: INSTALL Lines on Contour
4 ~~Drop~~ Rocks Keep 15 ft From DRAIN
REPAIR

Comments/Conditions:

INITIAL SITE SKETCH

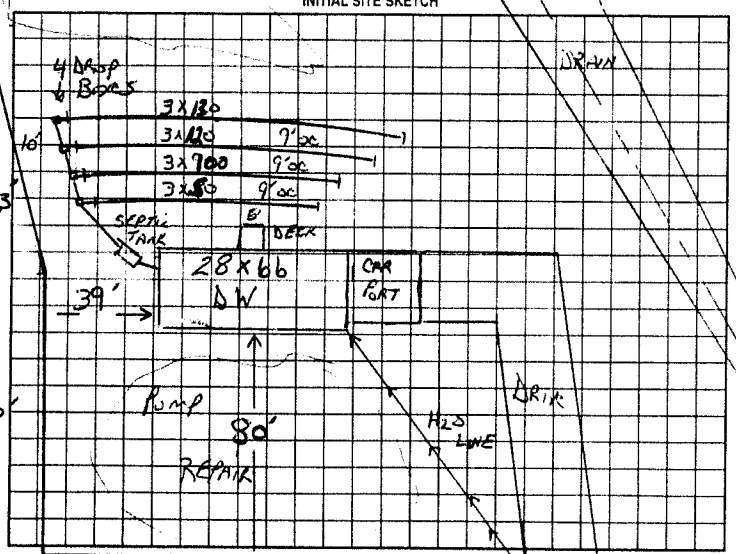

AS BUILT SKETCH

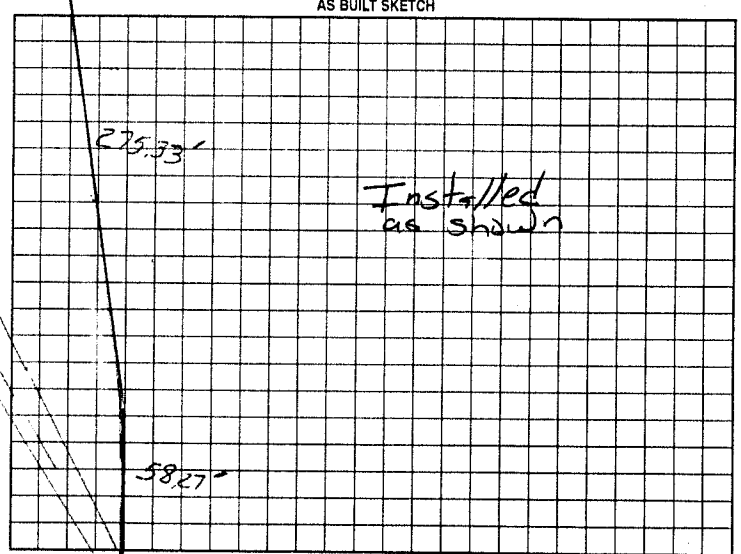

Permit can be suspended or revoked if any false information is supplied toward securing the permit/any unauthorized changes are made to the site/any unauthorized changes are made in the installation of the system. Improvement Permit with plat valid without expiration. Improvement Permit with site plan valid for sixty months. Authorization to Construct is valid for a period equal to that of Improvement Permit – not to exceed sixty months.

Signed: Dawn Brown date

Improvement Permit by: JC Potter date 3 23 99

Authorization to Construct by: JC Potter date 3 23 99

Installed by: A-1 Backhoe

Operation Permit by: Matt Conf 125 date 4-14-99

Existing System Inspection by: date

HEALTH DEPT COPY: WHITE OWNER COPY (FINAL) YELLOW OWNER COPY (INITIAL) PINK