IREDELL COUNTY HEALTH DEPARTMENT

STATESVILLE 704-878-5305 MOORESVILLE 704-664-5281

IMPROVEMENT PERMIT / AUTHORIZATION TO CONSTRUCT / OPERATION PERMIT / EXISTING SYSTEM INSPECTION

PERMIT# 077452 PIN# 4702 74 8724 DATE 11-4-98

OWNER OR CONTRACTOR CRYSTAL CLAYTON PHONE: Business Home 895-2856

ADDRESS P.O. BOX 768 HUNTERSVILLE NC 28078

LOCATION BUFFALO SHOALS ROAD, TR'EUFOLA ROAD, TL' BARBARY DRIVE, 9TH LOT ON RIGHT

SUBDIVISION LANSDOWNE BLOCK / SECTION LOT 48 LOT AREA 2.01 ACRES SITE CLASS PS DESIGN FLOW 360 L.T.A.R. 0.80 GPD/FT²

Septic Tank: 1000 Gallons: STB 1012 Date 11 3 98
Pump Tank: Gallons: PT Date
Pump Make: Model Serial No.
Nitrification Field: No Fields 1 Square Feet 1200 Linear Feet 400
No Lines FOUR Trench Width 36" Max Trench Bottom Depth 36' Gravel Depth 12"

☑ New System ☐ Repair System Type: I II III IV V VI
System Description: CONVENTIONAL GRAVITY
Repair System Description: CONVENTIONAL GRAVITY
Maintenance Agreement Required: Yes ☑ No


☐ House/Mod Home ☑ Mobile Home ☐ Business ☐ Other
No Bedrooms 3 No Bathrooms 2 No Employees
Slab ☑ Crawl Space Basement w/plumbing Basement wo/plumbing

Water Supply: ☐ Individual ☑ Public ☐ Community


Comments:/Conditions: PROPERTY LINE

Comments/Conditions: 417.06' C.M.

INITIAL SITE SKETCH

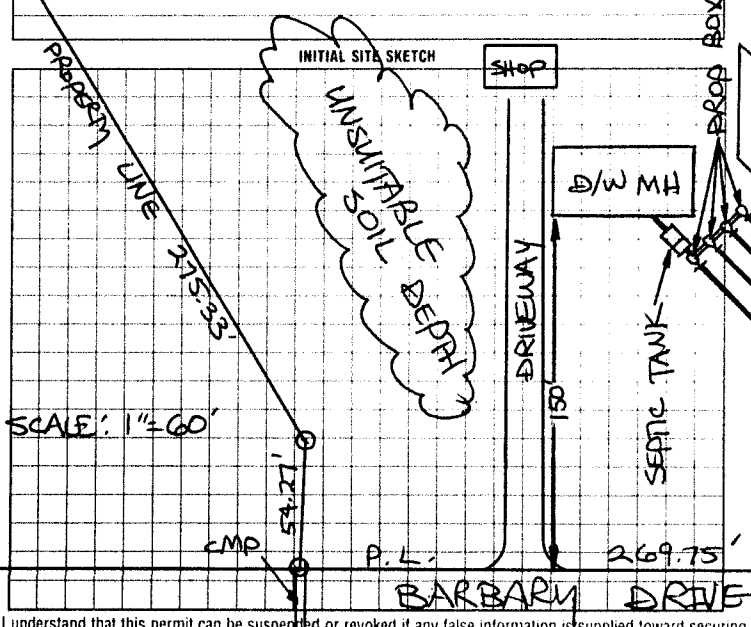

AS BUILT SKETCH

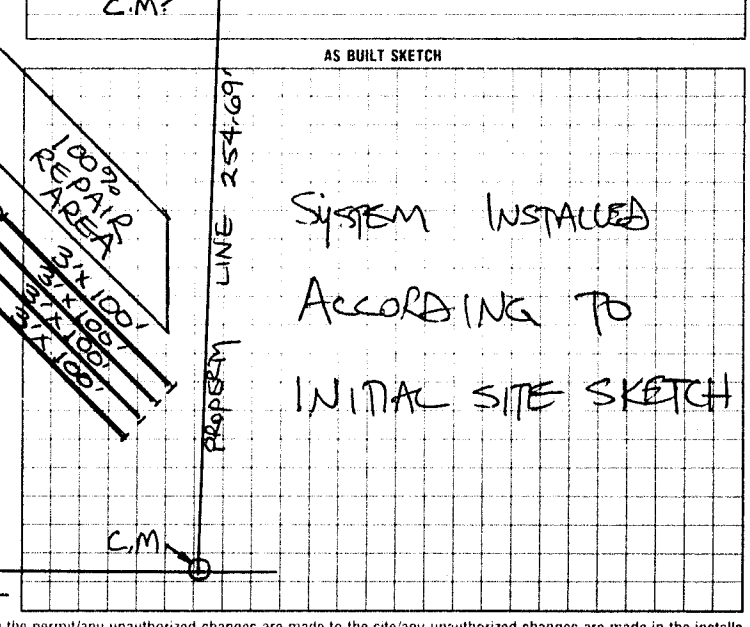

I understand that this permit can be suspended or revoked if any false information is supplied toward securing the permit/any unauthorized changes are made to the site/any unauthorized changes are made in the installation of the system. Improvement Permit with plat valid without expiration. Improvement Permit with site plan valid for sixty months. Authorization to Construct is valid for a period equal to that of Improvement Permit – not to exceed sixty months.

Signed: Crystal G. Clayton date 11-6-98 Installed by: RICHARD ABERNATHY

Improvement Permit by: STEVE HEDRICK date 11-4-98 Operation Permit by: STEVE HEDRICK date 2-8-99

Authorization to Construct by: STEVE HEDRICK date 11-4-98 Existing System Inspection by: date

HEALTH DEPT. COPY: WHITE INSPECTION COPY (FINAL): GREEN OWNER COPY (FINAL): YELLOW INSPECTION COPY (INITIAL): PINK OWNER COPY (INITIAL): GOLD