IREDELL COUNTY HEALTH DEPARTMENT

STATESVILLE 704-878-5305 MOORESVILLE 704-664-5281

IMPROVEMENT PERMIT / AUTHORIZATION TO CONSTRUCT / OPERATION PERMIT / EXISTING SYSTEM INSPECTION

4 sch 30 3/4" taps 6" sch 30 pvc 2" supply

PERMIT# 123735 / 128469 PIN# 4702-77-5027 4702-77-5027 BUILDER JEFF NICHOLSON DATE 2-20-05

OWNER OR CONTRACTOR CLARKS CHAPEL CHURCH PHONE: Business 828-433-6364 / 828-413-4993 Home 704-872-6001

ADDRESS 806 EUFOLA RD STATESVILLE, NC 28625 MOBILE # OFFICE #

LOCATION 70 WEST (L) EUFOLA (R) CLARK CHAPEL CHURCH (REDUCED FLOW BY H2O DATA)

SUBDIVISION — BLOCK / SECTION — LOT — LOT AREA 6.73+36.92 SITE CLASS. PS DESIGN FLOW 1200 GPD L.T.A.R. .3

Septic Tank: 2000 Gallons; STB 332 Date 6-24-04

Pump Tank: 2000 Gallons; PT 300 Date 6-25-04

Pump Make: GOULDS Model WE07J1H Serial No.

Nitrification Field: No Fields 1 Square Feet EA=4000 Linear Feet 1000

No Lines 10x100' Trench Width 36" Max Trench Bottom Depth 36" Gravel Depth N/A

[X] New System [ ] Repair System Type: I, II, [III], IV, V, VI

System Description: PUMP 25% REDUCT

Repair System Description: SAME

Maintenance Agreement Required: [ ] Yes [X] No

[ ] House/Mod. Home No. Bedrooms

[ ] Mobile Home No. Bathrooms 6

[ ] Business No. Employees 715

[X] Other CHURCH/NO KITCHEN

[X] Slab [ ] Crawl Space [ ] Basement w/plumbing [ ] Basement wo/plumbing

Water Supply: [ ] Individual [X] Public [ ] Community


Comments:/Conditions:

SEE ATTACHED COMMENT PAGE


Comments:/Conditions:

THIS PERMIT REPLACES PREVIOUSLY ISSUED PERMIT DATED 11-3-04. FLOW REDUCTION DATA WAS SUBMITTED

INITIAL SITE SKETCH

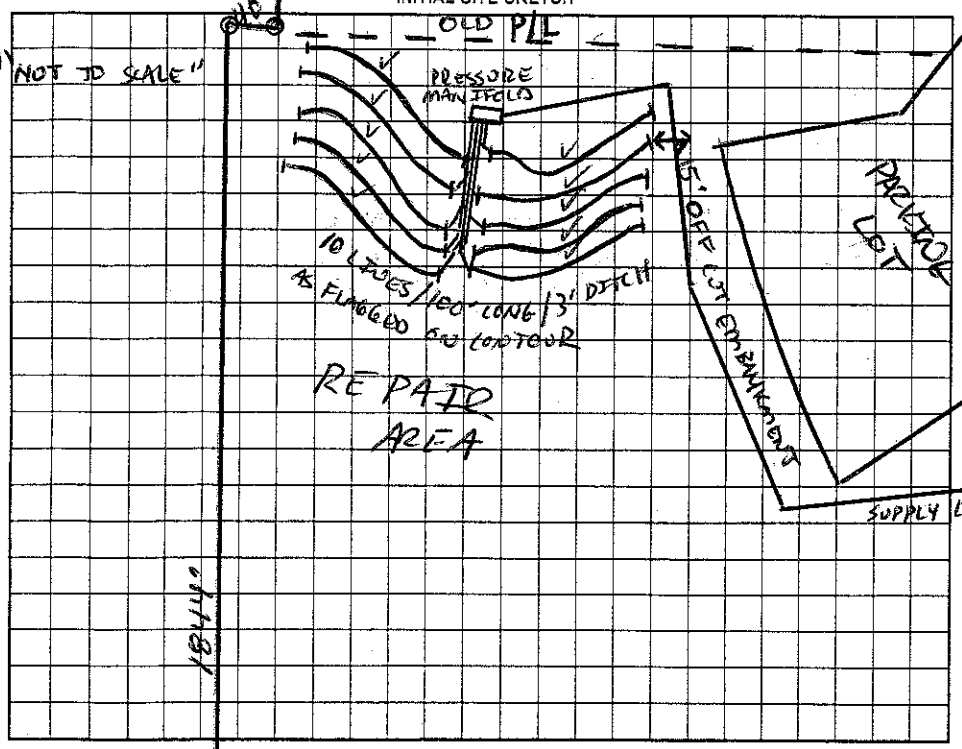

AS BUILT SKETCH

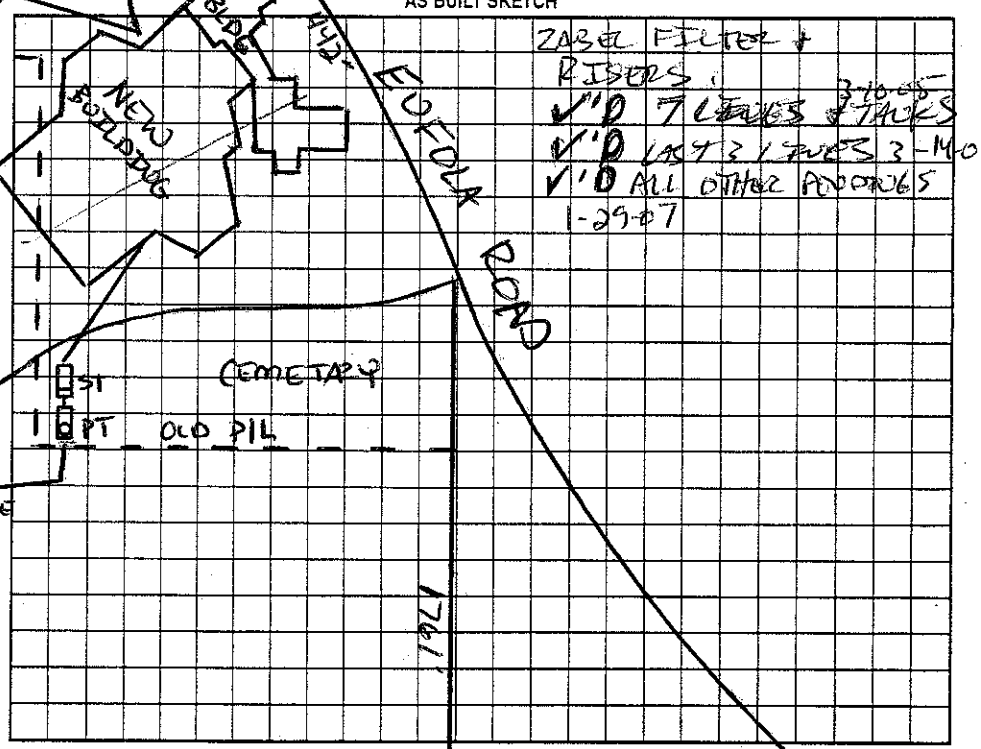

ZABEL FILTER # RISERS:

✓'D 7 LATERALS 3-10-05

✓'D LAST 3 LINES 3-14-05

✓'D ALL OTHER LINES 1-29-07

Permit can be suspended or revoked if any false information is supplied toward securing the permit/any unauthorized changes are made to the site/any unauthorized changes are made in the installation of the system. Improvement Permit with plat valid without expiration. Improvement Permit with site plan valid for sixty months. Authorization to Construct is valid for a period equal to that of Improvement Permit – not to exceed sixty months.

Signed: 2-22-05 date Installed by: BRADSHAW GRADING

Improvement Permit by: RS date 2-20-05 Operation Permit by: RS date 2-21-07

Authorization to Construct by: RS date 2-22-05 Existing System Inspection by: date

HEALTH DEPT. COPY: WHITE OWNER COPY (FINAL): YELLOW OWNER COPY (INITIAL): PINK