IREDELL COUNTY HEALTH DEPARTMENT

STATESVILLE 704-878-5305 MOORESVILLE 704-664-5281

IMPROVEMENT PERMIT / AUTHORIZATION TO CONSTRUCT / OPERATION PERMIT / EXISTING SYSTEM INSPECTION

PERMIT# 27537 PIN# 4702758164 DATE Feb 8 2000

OWNER OR CONTRACTOR Kings Forest PHONE: Business 552 6525 Home

ADDRESS 5551 Monroe Rd Charlotte NC

LOCATION Old Mtrd Sth (A) Elevis Ferry (L) Eufaula (R) Barlowe Lot on Right

SUBDIVISION Lansdowne BLOCK / SECTION LOT 50 LOT AREA 1.03 SITE CLASS FS DESIGN FLOW 360 L.T.A.R. .3

Septic Tank: 1000 Gallons; STB 1012 Date 1-7-01
Pump Tank: Gallons; PT Date
Pump Make: Model Serial No.
Nitrification Field: No Fields 1 Square Feet 1200 Linear Feet 400
No Lines 4 Trench Width 36" Max Trench Bottom Depth 36" Gravel Depth 12"


☒ New System ☐ Repair System Type: I, II, III, IV, V, VI
System Description: Gravity Conventional
Repair System Description: 25% Rule Possible
Maintenance Agreement Required: ☐ Yes ☒ No

☐ House/Mod. Home ☒ Mobile Home ☐ Business ☐ Other
No. Bedrooms 3 No. Bathrooms 2 No. Employees
☐ Slab ☒ Crawl Space ☐ Basement w/plumbing ☐ Basement wo/plumbing

Water Supply: ☐ Individual ☒ Public ☐ Community


Comments/Conditions: May use flow divider Tees (3) 10' 4 Way Boxes

INITIAL SITE SKETCH

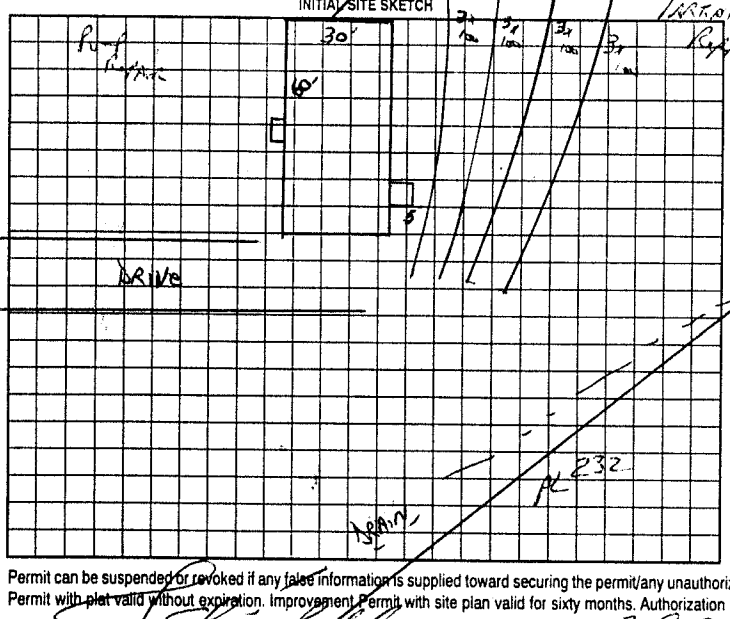

Comments/Conditions: (1) NO CUTTING OR FILLING OVER DRAINFIELD/REPAIR AREAS (2) KEEP ALL DRAINS AWAY FROM DRAINFIELD AND REPAIR AREAS (3) PUMP SEPTIC TANK EVERY 3 5 YRS.

AS BUILT SKETCH

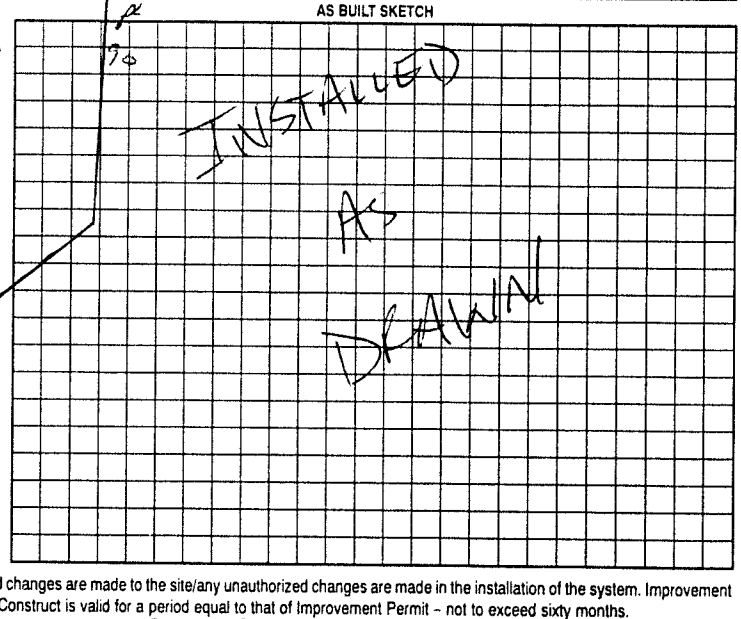

Permit can be suspended or revoked if any false information is supplied toward securing the permit/any unauthorized changes are made to the site/any unauthorized changes are made in the installation of the system. Improvement Permit with plat valid without expiration. Improvement Permit with site plan valid for sixty months. Authorization to Construct is valid for a period equal to that of Improvement Permit - not to exceed sixty months.

Signed: date 2-9-2000 Installed by: A-1 BACKHOE

Improvement Permit by: date Feb 8 2000 Operation Permit by: date 3/6/01

Authorization to Construct by: date Feb 8 2000 Existing System Inspection by: date

PC 63

HEALTH DEPT. COPY: WHITE OWNER COPY (FINAL): YELLOW OWNER COPY (INITIAL): PINK