IREDELL COUNTY HEALTH DEPARTMENT

STATESVILLE 704-878-5305 MOORESVILLE 704-664-5281

IMPROVEMENT PERMIT / AUTHORIZATION TO CONSTRUCT / OPERATION PERMIT / EXISTING SYSTEM INSPECTION

PERMIT# 19840 PIN# 4702 75 8552 DATE 3-29-99

OWNER OR CONTRACTOR Peggy Pate PHONE: Business 704 576 6791 Home

ADDRESS 94 Wildcat Ridge Cir Mooresville NC

LOCATION on RIGHT in Lansdowne off Eidson Rd

SUBDIVISION Lansdowne BLOCK / SECTION LOT 52 LOT AREA .67 Ac SITE CLASS P3 DESIGN FLOW 360 L.T.A.R. .13

Septic Tank: 1000 Gallons; STB 1012 Date 2-18-99
Pump Tank: Gallons; PT Date
Pump Make: Model Serial No.
Nitrification Field: No Fields 1 /Square Feet 1029 Linear Feet 350
No. Lines 5 Trench Width 36" Max Trench Bottom Depth 36" Gravel Depth 12"

☐ New System ☐ Repair System Type: ☐ I ☒ III, IV, V, VI
System Description: Conv. GRAVITY
Repair System Description: 25% Reduction
Maintenance Agreement Required: ☐ Yes ☒ No


☐ House/Mod. Home ☒ Mobile Home ☐ Business ☐ Other
No. Bedrooms 3 No. Bathrooms 2 No. Employees
☐ Slab ☒ Crawl Space ☐ Basement w/plumbing ☐ Basement wo/plumbing

Water Supply: ☐ Individual ☒ Public ☐ Community

Comments/Conditions: Install lines on Contour Repair 25% Reduction

Repair

INITIAL SITE SKETCH

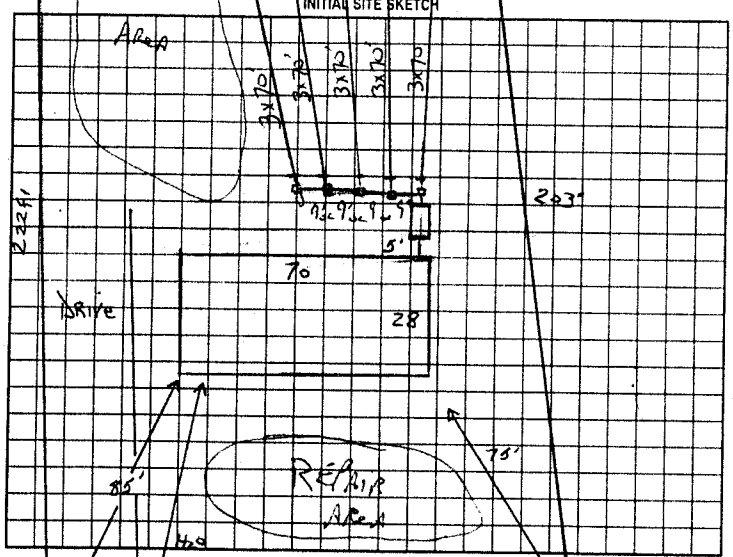

Comments/Conditions:

AS BUILT SKETCH

Installed as shown

Permit can be suspended or revoked if any false information is supplied toward securing the permit/any unauthorized changes are made to the site/any unauthorized changes are made in the installation of the system. Improvement Permit with plat valid without expiration. Improvement Permit with site plan valid for sixty months. Authorization to Construct is valid for a period equal to that of Improvement Permit – not to exceed sixty months.

Signed: Rick Pate Property Owner date

Improvement Permit by: [signature] date 3-30-99

Authorization to Construct by: [signature] date 3-30-99

Installed by: C&W Septic

Operation Permit by: [signature] date 4-16-99

Existing System Inspection by: date

HEALTH DEPT. COPY: WHITE OWNER COPY (FINAL): YELLOW OWNER COPY (INITIAL): PINK