IREDELL COUNTY HEALTH DEPARTMENT

STATESVILLE 704-878-5305 MOORESVILLE 704-664-5281

IMPROVEMENT PERMIT / AUTHORIZATION TO CONSTRUCT / OPERATION PERMIT / EXISTING SYSTEM INSPECTION

PERMIT# 80673 PIN# 4702758655 DATE 4-26-99

OWNER OR CONTRACTOR LARRY Hudson PHONE: Business 873 3731 Home 828 478 3970

ADDRESS 1807 Molly's Backbone Rd Sherrills Ford

LOCATION Lot 53 Lansdowne Eufola Rd @ Barbary Rd 4th Lot on Right

SUBDIVISION Lansdowne BLOCK / SECTION ____ LOT 53 LOT AREA ~1.2 SITE CLASS PS DESIGN FLOW 360 L.T.A.R. .3

Septic Tank: 1000 Gallons; STB 312 Date 4 26 99
Pump Tank: ____ Gallons; PT ____ Date ____
Pump Make: ____ Model ____ Serial No. ____
Nitrification Field: No Fields 1 Square Feet 1200 Linear Feet 1200
No Lines 5 Trench Width 36 Max Trench Bottom Depth 48" Gravel Depth 12"

☒ New System ☐ Repair System Type: I (II) III IV V VI
System Description: Conv. Gravity
Repair System Description: 25% Reduction / Pump
Maintenance Agreement Required: ☐ Yes ☒ No

☒ House/Mod. Home No. Bedrooms 3
☐ Mobile Home No. Bathrooms 2
☐ Business No. Employees ____
☐ Other ____


☐ Slab ☒ Crawl Space ☐ Basement w/plumbing ☐ Basement wo/plumbing

Water Supply: ☐ Individual ☒ Public ☐ Community


Comments/Conditions: Landscape To provide adequate drainage

Comments/Conditions

INITIAL SITE SKETCH

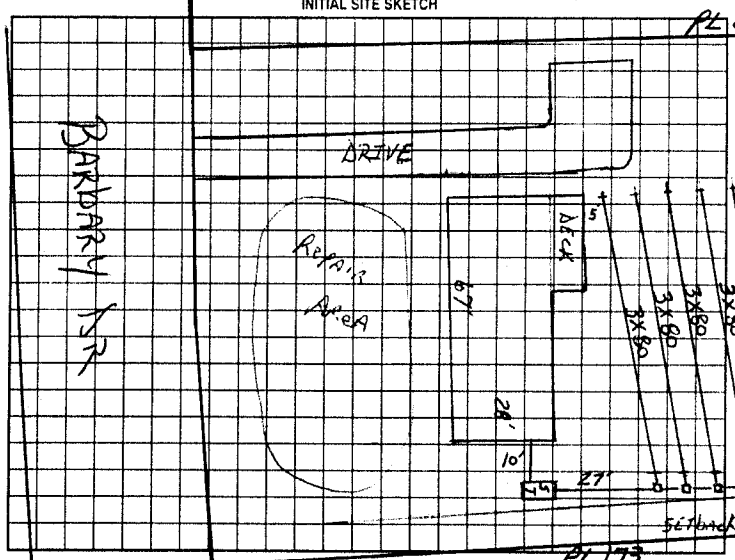

AS BUILT SKETCH

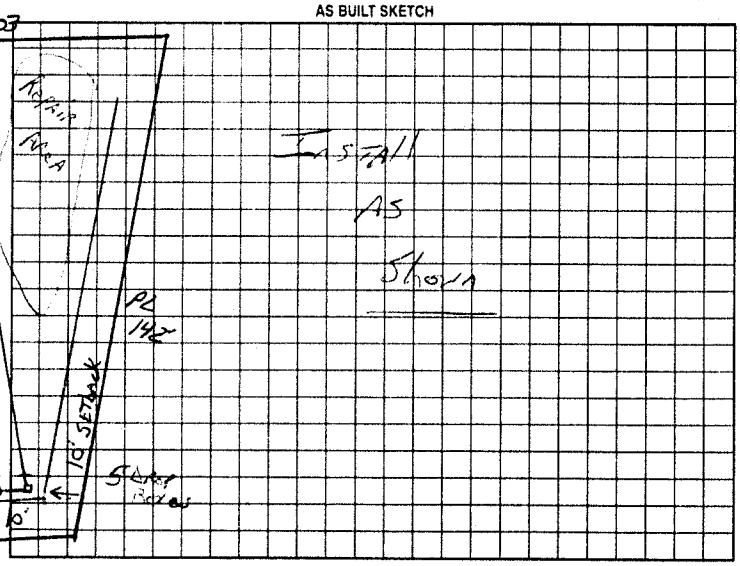

Permit can be suspended or revoked if any false information is supplied toward securing the permit/any unauthorized changes are made to the site/any unauthorized changes are made in the installation of the system. Improvement Permit with plat valid without expiration. Improvement Permit with site plan valid for sixty months. Authorization to Construct is valid for a period equal to that of Improvement Permit – not to exceed sixty months.

Signed: Larry Hudson date 4/28/99 Installed by: Cody Co

Improvement Permit by: J. C. Potter date 4 26 99 Operation Permit by: J. C. Potter date May 28 99

Authorization to Construct by: J. C. Potter date 4 26 99 Existing System Inspection by ____ date ____

HEALTH DEPT. COPY: WHITE OWNER COPY (FINAL): YELLOW OWNER COPY (INITIAL): PINK