# IREDELL COUNTY HEALTH DEPARTMENT

STATESVILLE 704-878-5305 (C1) MOORESVILLE 704-664-5281

## (1) IMPROVEMENT PERMIT / AUTHORIZATION TO CONSTRUCT / OPERATION PERMIT / EXISTING SYSTEM INSPECTION

PERMIT# 107740 PIN# 4702-77-1454 DATE 7-26-02

OWNER OR CONTRACTOR FOREST SIMFORD PHONE: Business (704) 902-2102 Home (704) 883-0574

ADDRESS 764 EUFOLA ROAD STATESVILLE, NC 28677

LOCATION OLD MOUNTAIN ROAD TO LEWIS FERRY ROAD, TL EUFOLA ROAD, MH ON RIGHT AT # 764

SUBDIVISION _____ BLOCK / SECTION _____ LOT _____ LOT AREA 2 ACRES SITE CLASS PS DESIGN FLOW 240 L.T.A.R. 0.40 GPD/FT²

Septic Tank: 1000 Gallons, STB 1012 Date 6-26-02
Pump Tank: _____ Gallons; PT _____ Date _____
Pump Make: _____ Model _____ Serial No. _____
Nitrification Field: No Fields 1 Square Feet 600 Linear Feet 200
No Lines THREE Trench Width 36" Max Trench Bottom Depth 30" Gravel Depth 12"

☒ New System ☐ Repair System Type: I (II) III. IV. V VI
System Description: CONVENTIONAL GRAVITY
Repair System Description: 50% REDUCTION, GRAVITY
Maintenance Agreement Required: ☐ Yes ☒ No
☐ Slab ☑ Crawl Space ☐ Basement w/plumbing ☐ Basement wo/plumbing


☐ House/Mod. Home No. Bedrooms 2/2
☒ Mobile Home No. Bathrooms 2/2
☐ Business No. Employees ____
☐ Other ____

Water Supply: ☒ Individual ☐ Public ☐ Community
WELL NEXT DOOR


Comments:/Conditions:

Comments:/Conditions: (1) SEPTIC TANK WITH RISERS AND MARKER INSTALLED USING "PolyLok" FILTER.
(2) LOWER TWO LINES & PART OF UPPER LINE INSPECTED 10-15-02, RSH.

INITIAL SITE SKETCH

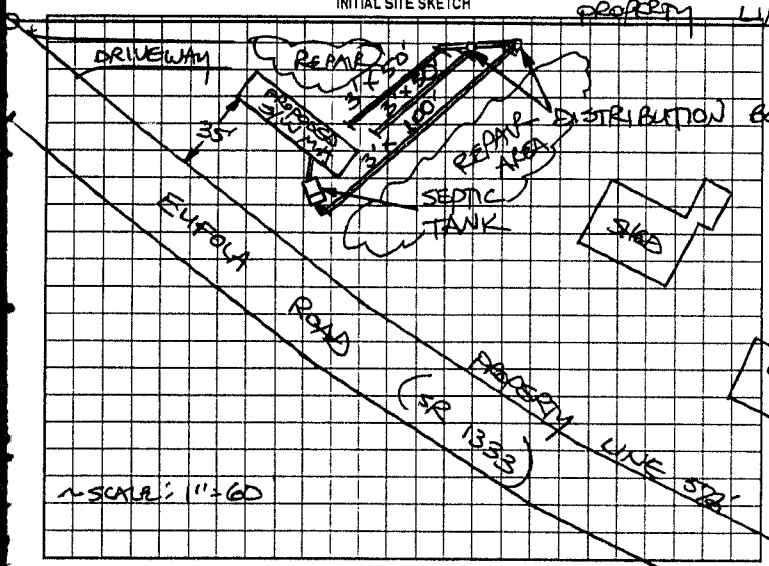


AS BUILT SKETCH

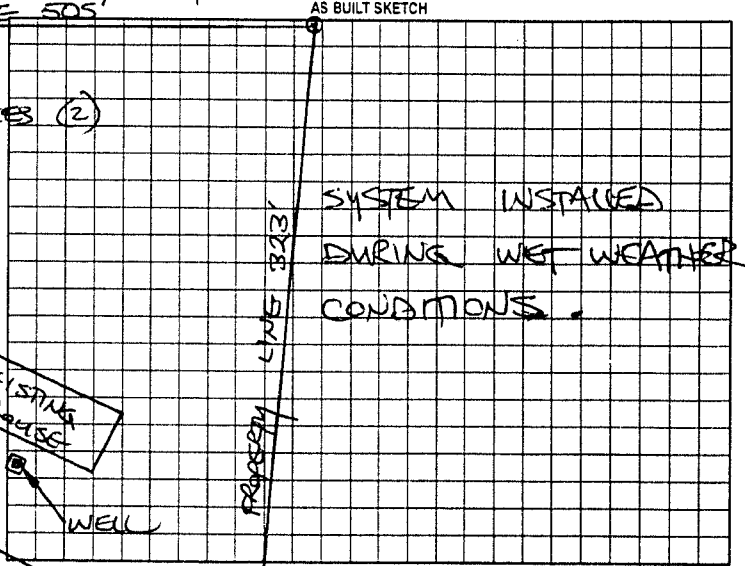


Permit can be suspended or revoked if any false information is supplied toward securing the permit, any unauthorized changes are made to the site/any unauthorized changes are made in the installation of the system. Improvement Permit with plat valid without expiration. Improvement Permit with site plan valid for sixty months. Authorization to Construct is valid for a period equal to that of Improvement Permit – not to exceed sixty months.

Signed: [signature] date 7-26-02 Installed by: FOREST SIMFORD

Improvement Permit by: STEVE HEDRICK date 7-26-02 Operation Permit by: STEVE HEDRICK date 10-28-02

Authorization to Construct by: STEVE HEDRICK date 7-26-02 Existing System Inspection by: _____ date _____

HEALTH DEPT. COPY: WHITE OWNER COPY (FINAL): YELLOW OWNER COPY (INITIAL): PINK