IREDELL COUNTY HEALTH DEPARTMENT

STATESVILLE 704-878-5305 MOORESVILLE 704-664-5281

IMPROVEMENT PERMIT / AUTHORIZATION TO CONSTRUCT / OPERATION PERMIT / EXISTING SYSTEM INSPECTION

PERMIT# 109015 PIN# 4702-77-~~8688~~ 2726 DATE 09/30/02

OWNER OR CONTRACTOR QUAIL HOLLOW BUILDING COMPANY PHONE: Business 704-528-0598 Home

ADDRESS 212 CANAL DRIVE STATESVILLE, NC 28677

LOCATION OLD MOUNTAIN RD, SOUTH, (R) LEWIS FERRY, (L) LAMB RD., LOT ON LEFT CORNER OF LAMB & EUFOLA ROADS

SUBDIVISION — BLOCK / SECTION — LOT — LOT AREA 5.0 ACRES SITE CLASS. PS DESIGN FLOW 360 GPD L.T.A.R. 0.30

Septic Tank: 1,000 Gallons; STB 1012 Date 10/04/02
Pump Tank: Gallons; PT Date
Pump Make: Model Serial No.
Nitrification Field: No Fields 1 Square Feet 1,200 Linear Feet 400
No Lines 4 x 100' Trench Width 36" Max Trench Bottom Depth 36" Gravel Depth 12"

☒ New System ☐ Repair System Type: I, II, III, IV, V, VI
System Description: CONVENTIONAL GRAVITY
Repair System Description: SAME
Maintenance Agreement Required: ☐ Yes ☒ No


☒ House/Mod. Home No. Bedrooms 3
☐ Mobile Home No. Bathrooms 2½
☐ Business No. Employees
☐ Other
☐ Slab ☒ Crawl Space ☐ Basement w/plumbing ☐ Basement wo/plumbing

Water Supply: ☐ Individual ☒ Public ☐ Community


Comments/Conditions: (1) INSTALL LINES ON CONTOUR (2) MAINTAIN ALL SETBACKS, (3) SYSTEM & REPAIR MUST BE 100' PLUS FROM NEIGHBORING WELL (SAPROLITE RULE)

Comments/Conditions: - SEPTIC TANK INSTALLED USING TUFF-TIGHT FILTER & TANK MARKER.
* TRENCHES RAINED IN.
* SYSTEM INSTALLED DURING WET SOIL CONDITIONS.

INITIAL SITE SKETCH

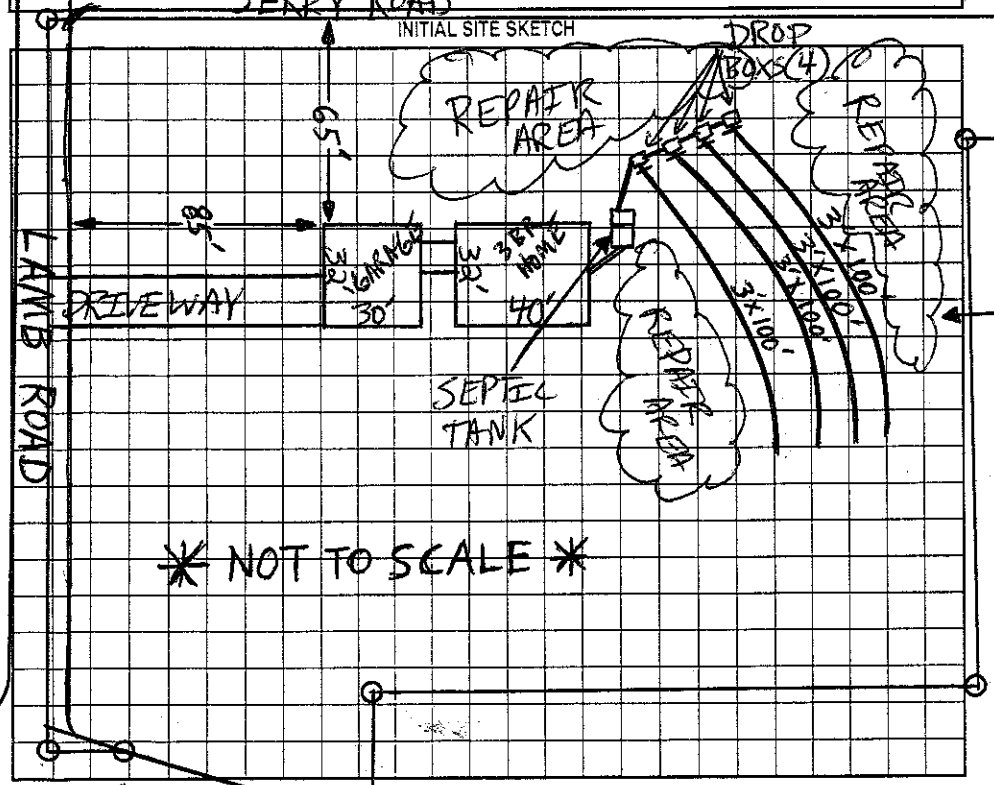

AS BUILT SKETCH

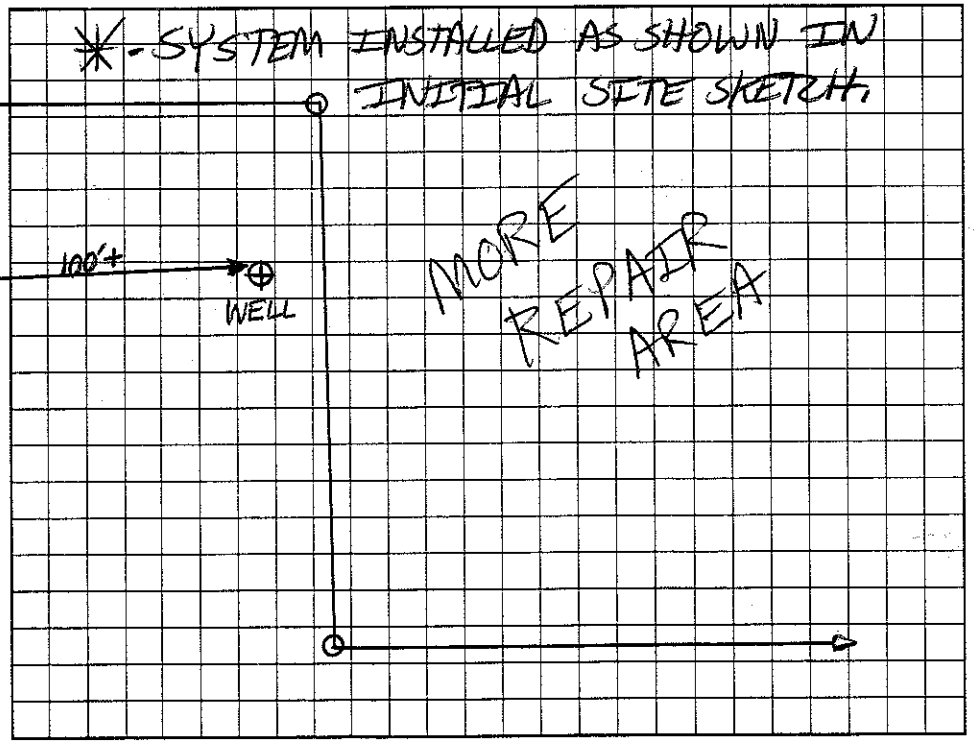

Permit can be suspended or revoked if any false information is supplied toward securing the permit/any unauthorized changes are made to the site/any unauthorized changes are made in the installation of the system. Improvement Permit with plat valid without expiration. Improvement Permit with site plan valid for sixty months. Authorization to Construct is valid for a period equal to that of Improvement Permit – not to exceed sixty months.

Signed: [signature] date 09/30/02 Installed by: FOREST SHUFORD 02-26-03

Improvement Permit by: Patrick Mitchell date 09/30/02 Operation Permit by: Patrick Mitchell date 02/26/03

Authorization to Construct by: Patrick Mitchell date 09/30/02 Existing System Inspection by: date

HEALTH DEPT. COPY: WHITE OWNER COPY (FINAL): YELLOW OWNER COPY (INITIAL): PINK