IREDELL COUNTY HEALTH DEPARTMENT

STATESVILLE 704-878-5305 MOORESVILLE 704-664-5281

IMPROVEMENT PERMIT / AUTHORIZATION TO CONSTRUCT / OPERATION PERMIT / EXISTING SYSTEM INSPECTION

PERMIT# REPAIR PIN# 4702 77 5027 DATE 6-11-01

OWNER OR CONTRACTOR CLARKS CHAPEL BAPTIST CHURCH PHONE: Business C/O (704) 878-5659 Home (704) 872-6001

ADDRESS P.O. BOX 5098 STATESVILLE, NC 28687

LOCATION US 70 WEST TL EUFOLA ROAD, CHURCH ON RIGHT PAST LAMB ROAD

SUBDIVISION _____ BLOCK / SECTION _____ LOT _____ LOT AREA 43.165 ACRES SITE CLASS PS DESIGN FLOW 750 L.T.A.R. EXISTING 0.55 AR/AC

Septic Tank: 1500 Gallons: STB 338 Date 9-4-01
Pump Tank: _____ Gallons: PT _____ Date _____
Pump Make: _____ Model _____ Serial No _____
Nitrification Field: No Fields 1 Square Feet 1260 Linear Feet 420
No Lines THREE Trench Width 36" Max Trench Bottom Depth 36" Gravel Depth 12"

☐ New System ☑ Repair System Type: I, II, (III), IV, V, VI
System Description CONVENTIONAL GRAVITY
Repair System Description: CONVENTIONAL GRAVITY
Maintenance Agreement Required: ☐ Yes ☑ No
☐ Slab ☑ Crawl Space ☐ Basement w/plumbing ☐ Basement wo/plumbing


☐ House/Mod Home No. Bedrooms ____
☐ Mobile Home No. Bathrooms ____
☐ Business No. Employees ____
☑ Other CHURCH 4250 @ 3GAD

Water Supply:
☐ Individual
☑ Public
☐ Community


Comments/Conditions: ABANDON EXISTING SEPTIC SYSTEM, CRUSH EXISTING TANK & FILL WITH CLAY SOIL FROM NEW TANK EXCAVATION.

Comments/Conditions: - Zabel Filter, Septic Tank Marker + Tante v. risers Installed.
2 Installed 3@ 155 Ft long

INITIAL SITE SKETCH

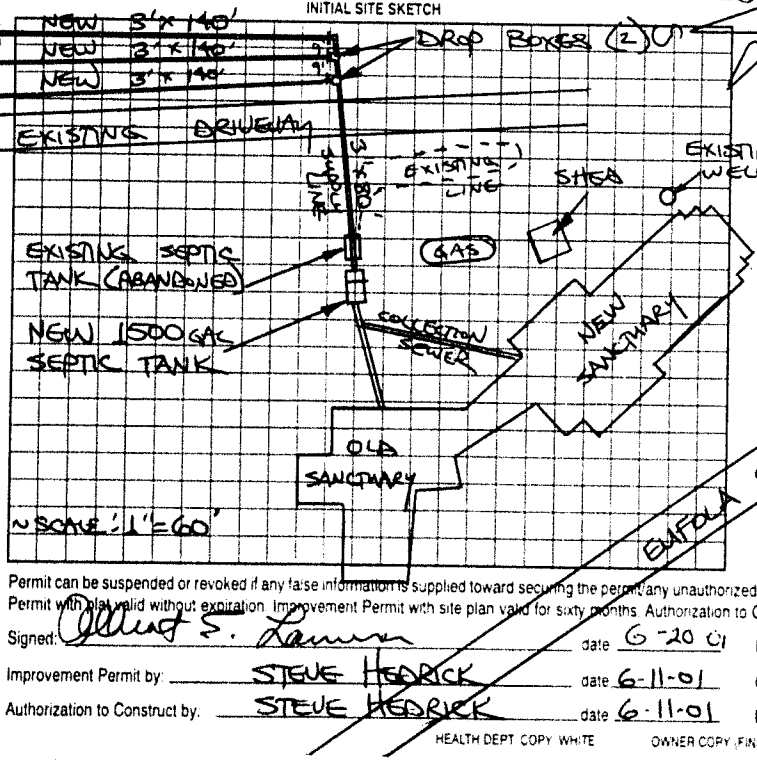

AS BUILT SKETCH

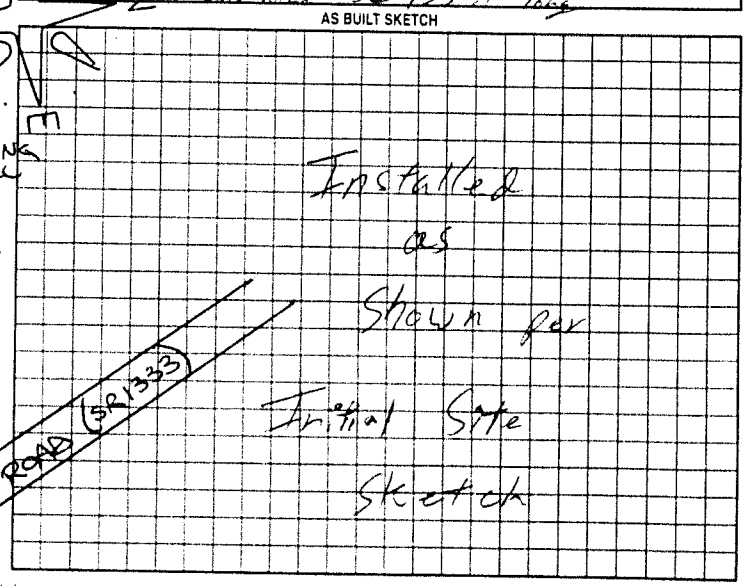

Permit can be suspended or revoked if any false information is supplied toward securing the permit, any unauthorized changes are made to the site, any unauthorized changes are made in the installation of the system. Improvement Permit with plat valid without expiration. Improvement Permit with site plan valid for sixty months. Authorization to Construct is valid for a period equal to that of Improvement Permit - not to exceed sixty months.

Signed: Clint S. Lamm date 6-20-01 Installed by Wes Lytton

Improvement Permit by: STEVE HEDRICK date 6-11-01 Operation Permit by William O. Johnson date 10/17/01

Authorization to Construct by: STEVE HEDRICK date 6-11-01 Existing System Inspection by _____ date _____

HEALTH DEPT COPY WHITE OWNER COPY (FINAL) YELLOW OWNER COPY (INITIAL) PINK