IREDELL COUNTY HEALTH DEPARTMENT

STATESVILLE 704-878-5305 CI MOORESVILLE 704-664-5281

IMPROVEMENT PERMIT / AUTHORIZATION TO CONSTRUCT / OPERATION PERMIT / EXISTING SYSTEM INSPECTION

PERMIT# 17088 PIN# 4702-72-2025 DATE 1-2-04

OWNER OR CONTRACTOR CLAYTON HOMES PHONE: Business 450-4817 Home

ADDRESS 2026 NORTHSIDE DR STATESVILLE, NC 28677

LOCATION 40 WEST, (L) ONR, (R) LEWIS FERRY, (L) LAMB ROAD, 3RD LOT ON RT

SUBDIVISION BLOCK / SECTION LOT LOT AREA .784 .04 SITE CLASS. PS DESIGN FLOW 360 L.T.A.R. .25

Septic Tank: 1000 Gallons; STB 1012 Date 7-29-03
Pump Tank: Gallons; PT Date
Pump Make: Model Serial No.
Nitrification Field: No Fields 1 Square Feet EQ=1440 Linear Feet 360'
No Lines 4x90' Trench Width 36" Max Trench Bottom Depth 36" Gravel Depth N/A

☒ New System ☐ Repair System Type: I, II, (III), IV, V, VI
System Description: 6RAW 2510 REDUCT
Repair System Description: LP PANEL
Maintenance Agreement Required: ☐ Yes ☒ No


☒ House/Mod. Home No. Bedrooms 3/2
☐ Mobile Home No. Bathrooms
☐ Business No. Employees
☐ Other
☐ Slab ☒ Crawl Space ☐ Basement w/plumbing ☐ Basement wo/plumbing


Water Supply: ☒ Individual ☐ Public ☐ Community
WELL

Comments/Conditions: ① CALL PRIOR TO INSTALLATION FOR CONSULTATIVE VISIT ② INSTALL LINES ON CONTOURS ③ MAINTAIN SETBACKS

Comments/Conditions: TOILETTE FILTER + MARKER
HOUSE/S/W NOT ON SITE AT TIME OF CHECK
SYSTEM INSTALLED AS DRAWN. DRAWN DRAIN OUTLET CHANGED AS DRAWN BELOW. LINES HAD 1"
FALL IN 90'. ALLOWED AS BUILT SKETCH BY RULES.

INITIAL SITE SKETCH "NOT TO SCALE"

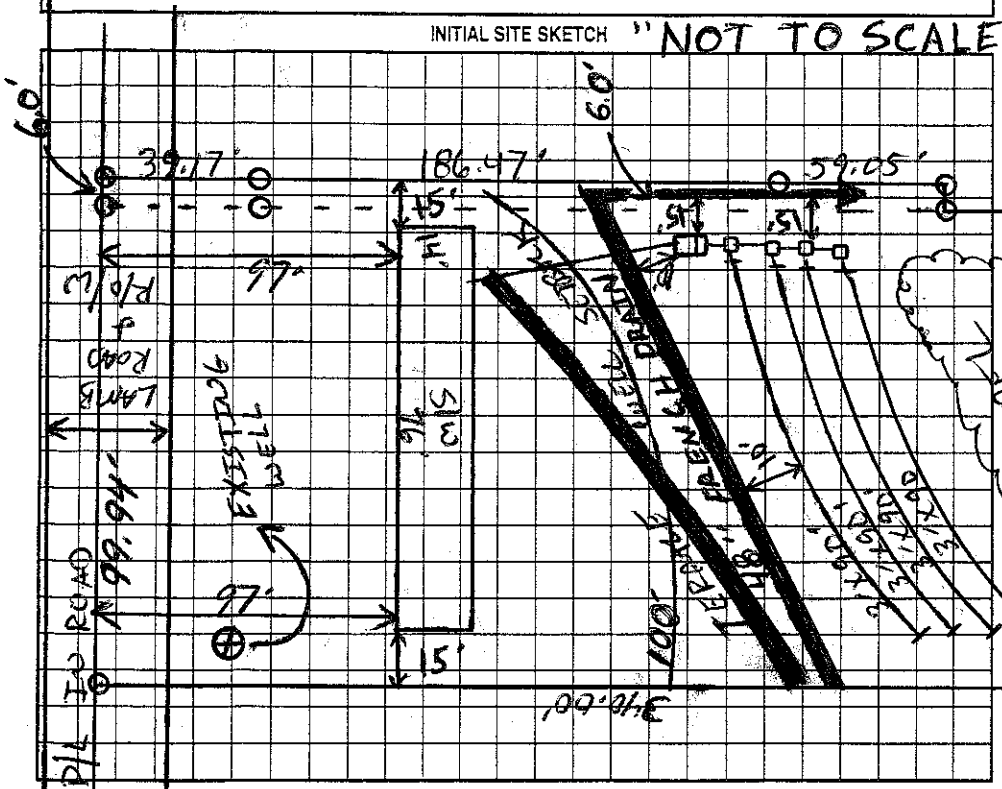

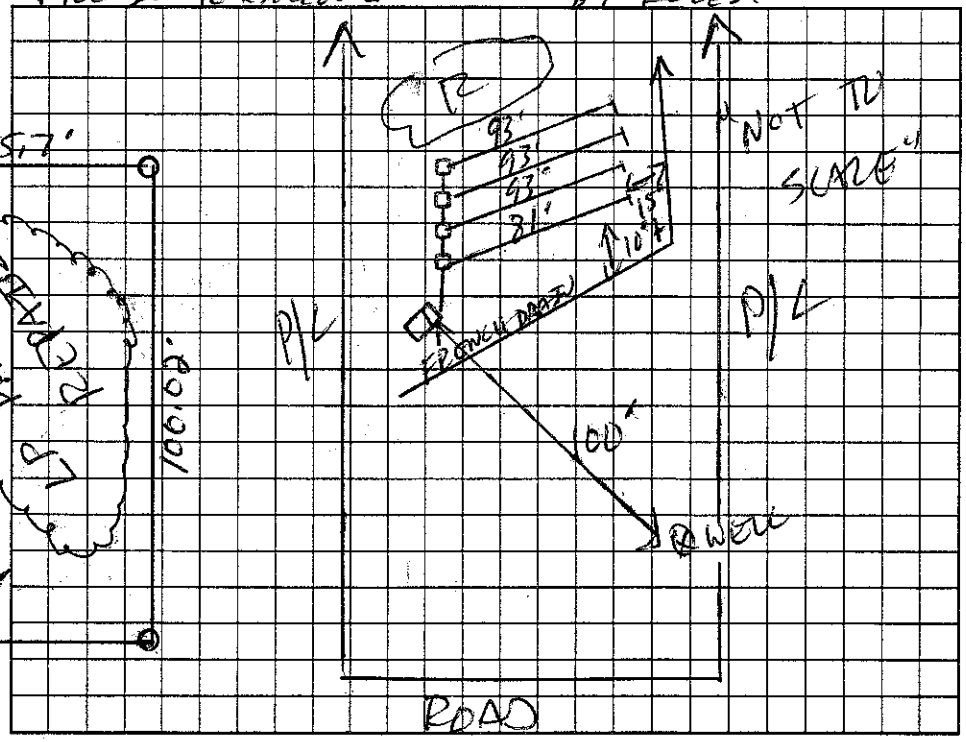

Permit can be suspended or revoked if any false information is supplied toward securing the permit/any unauthorized changes are made to the site/any unauthorized changes are made in the installation of the system. Improvement Permit with plat valid without expiration. Improvement Permit with site plan valid for sixty months. Authorization to Construct is valid for a period equal to that of Improvement Permit – not to exceed sixty months.

Signed: date 1/2/04 Installed by: A-1 BACKHOE

Improvement Permit by: date 1-2-04 Operation Permit by: date 1-6-04

Authorization to Construct by: date 1-2-04 Existing System Inspection by: date

HEALTH DEPT. COPY: WHITE OWNER COPY (FINAL): YELLOW OWNER COPY (INITIAL): PINK