...DELL COUNTY HEALTH DEPARTMENT

STATESVILLE 704-878-5305 MOORESVILLE 704-664-5281

IMPROVEMENT PERMIT / AUTHORIZATION TO CONSTRUCT / OPERATION PERMIT / EXISTING SYSTEM INSPECTION

PERMIT# 8170 7 PIN# 4752822689 DATE June 21 99

OWNER OR CONTRACTOR Kings Forest PHONE: Business 7045326527 Home

ADDRESS 5551 Monroe Rd Charlotte

LOCATION Lot 32 Lansdowne Barbary Rd on Left 0.5 Mile Rd.

SUBDIVISION Lansdowne BLOCK / SECTION LOT 32 LOT AREA .67 SITE CLASS. C5 DESIGN FLOW 360 L.T.A.R. .43

Septic Tank: 1000 Gallons; STB 798 Date 2-12-99

Pump Tank: Gallons; PT Date

Pump Make: Model Serial No.

Nitrification Field: No Fields 1 Square Feet 1200 Linear Feet 400

No Lines 3 Trench Width 36" Max Trench Bottom Depth 36"

☒ New System ☐ Repair System Type: I. ☐ II. ☐ III. ☐ IV. ☐ V. ☐ VI

System Description: Gravity Conv

Repair System Description: Same 25% Reduction

Maintenance Agreement Required: ☐ Yes ☒ No

Gravel Depth 12" ☐ Slab ☒ Crawl Space ☐ Basement w/plumbing ☐ Basement wo/plumbing

☐ House/Mod. Home No. Bedrooms 3

☒ Mobile Home DW No. Bathrooms 2

☐ Business No. Employees


☐ Other

Water Supply: ☐ Individual ☒ Public ☐ Community

Comments/Conditions: Install Gutters on entire 3 Drop Boxes

Comments/Conditions

INITIAL SITE SKETCH

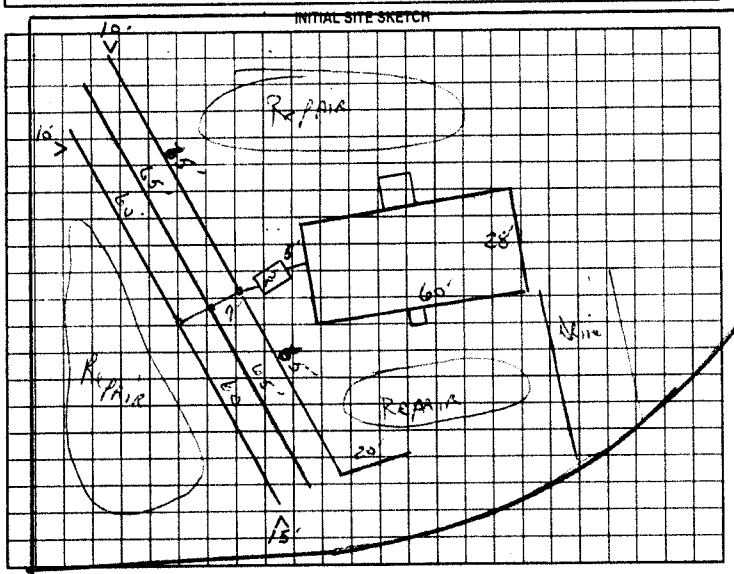

AS BUILT SKETCH

Permit can be suspended or revoked if any false information is supplied toward securing the permit/any unauthorized changes are made to the site/any unauthorized changes are made in the installation of the system. Improvement Permit with plat valid without expiration. Improvement Permit with site plan valid for sixty months. Authorization to Construct is valid for a period equal to that of Improvement Permit – not to exceed sixty months.

Signed: W Steve Sabella date 6/21/99

Improvement Permit by: J.C. Potter date 6/21/99

Authorization to Construct by: J.C. Potter date 6/21/99

Installed by: Dellinger Grading

Operation Permit by: J.C. Potter date 7-27-99

Existing System Inspection by: date

HEALTH DEPT. COPY WHITE OWNER COPY (FINAL) YELLOW OWNER COPY (INITIAL) PINK