# IREDELL COUNTY HEALTH DEPARTMENT

STATESVILLE 704-878-5305 MOORESVILLE 704-664-5281

## IMPROVEMENT PERMIT / AUTHORIZATION TO CONSTRUCT / OPERATION PERMIT / EXISTING SYSTEM INSPECTION

PERMIT# 076655 PIN# 4702 82 2863

OWNER OR CONTRACTOR TIM CREAGAN PHONE: Business DATE 10-10-98

ADDRESS 1042 CHARLOTTE HIGHWAY, TROUTMAN, NC 28166 Home 528-4516

LOCATION US 70 WEST, TL EUFOLA ROAD, TR BARBARY DRIVE, 4TH LOT ON RIGHT PAST COPPER CREEK DR.

SUBDIVISION LANSDOWNE BLOCK / SECTION LOT 33 LOT AREA 0.72 ACRE SITE CLASS. PS DESIGN FLOW 360 L.T.A.R. 0.30 GPD/FT²

Septic Tank: 1000 Gallons; STB 1012 Date 8-17-98

Pump Tank: Gallons; PT Date

Pump Make: Model Serial No.

Nitrification Field: No Fields 1 Square Feet 1200 Linear Feet 400

No Lines FIVE Trench Width 36" Max Trench Bottom Depth 28" Gravel Depth 12"

☑ New System ☐ Repair System Type: I, II, III, IV, V, VI

System Description: CONVENTIONAL GRAVITY

Repair System Description: 25% REDUCTION PUMP

Maintenance Agreement Required: ☐ Yes ☑ No

☐ House/Mod. Home ☑ Mobile Home ☐ Business ☐ Other

No. Bedrooms 3 No. Bathrooms 2 No. Employees


☐ Slab ☑ Crawl Space ☐ Basement w/plumbing ☐ Basement wo/plumbing

Water Supply: ☐ Individual ☑ Public ☐ Community


Comments:/Conditions: INSTALL SUBSURFACE INTERCEPT DRAINAGE DITCH AT LOCATION SHOWN BEGINNING 40 INCHES DEEP OUT TO DAYLIGHT

Comments:/Conditions: ① TANK & LINES INSTALLED 10-20-98 ② SUBSURFACE DRAIN REMAINS TO BE INSTALLED

INITIAL SITE SKETCH SCALE: 1" = 40'

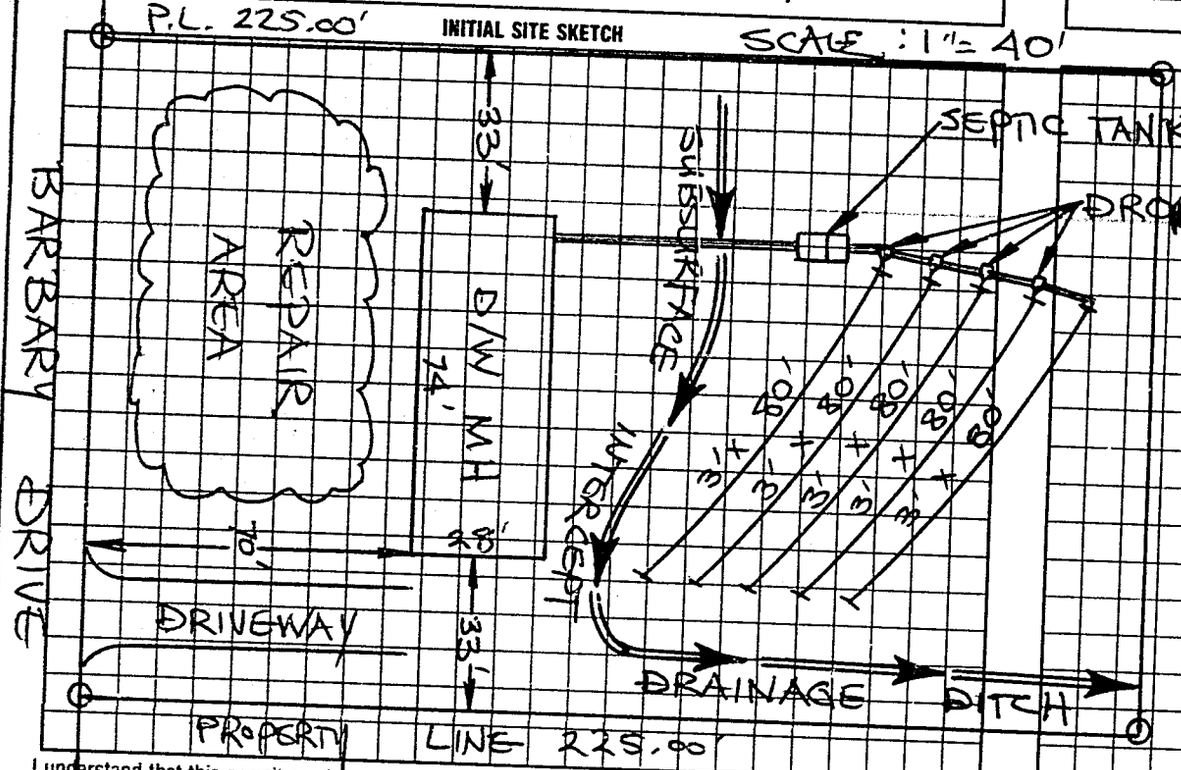


AS BUILT SKETCH

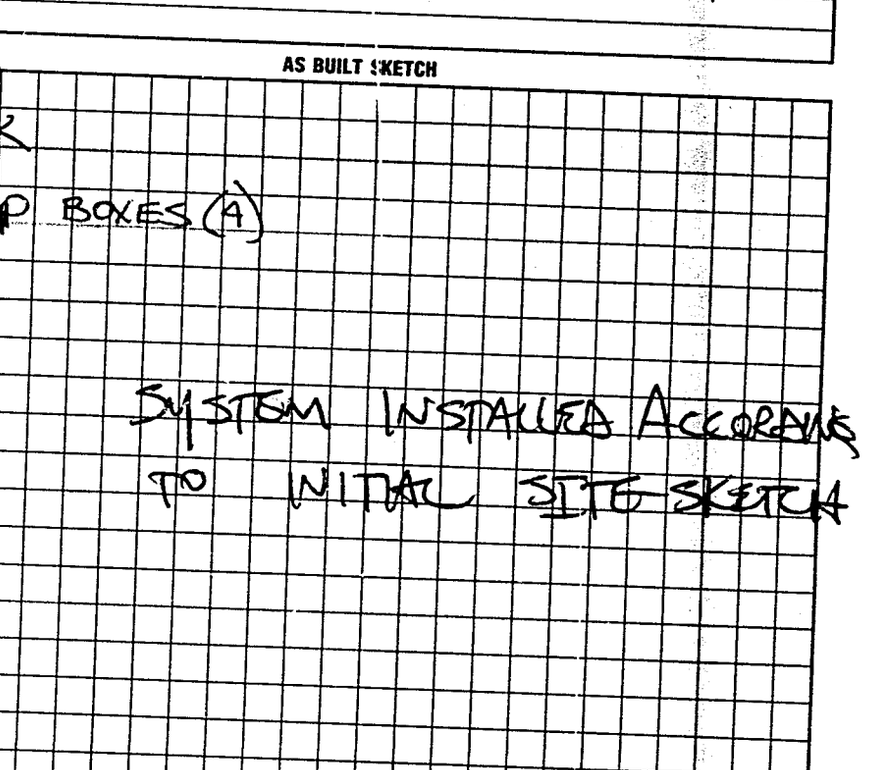


I understand that this permit can be suspended or revoked if any false information is supplied toward securing the permit/any unauthorized changes are made to the site/any unauthorized changes are made in the installation of the system. Improvement Permit with plat valid without expiration. Improvement Permit with site plan valid for sixty months. Authorization to Construct is valid for a period equal to that of Improvement Permit – not to exceed sixty months.

Signed: Amanda D Holley date 10-12-98

Improvement Permit by: STEVE HEDRICK date 10-10-98

Authorization to Construct by: STEVE HEDRICK date 10-10-98

Installed by: A-1 BACKHOE

Operation Permit by: STEVE HEDRICK date 10-22-98

Existing System Inspection by: date

HEALTH DEPT. COPY: WHITE INSPECTION COPY (FINAL): GREEN OWNER COPY (FINAL): YELLOW INSPECTION COPY (INITIAL): PINK OWNER COPY (INITIAL): GOLD