IREDELL COUNTY HEALTH DEPARTMENT

STATESVILLE 704-878-5305 MOORESVILLE 704-664-5281

IMPROVEMENT PERMIT / AUTHORIZATION TO CONSTRUCT / OPERATION PERMIT / EXISTING SYSTEM INSPECTION

PERMIT# 976461 PIN# 4702 82 2946

OWNER OR CONTRACTOR ROBERT STARR DATE 10-3-98

ADDRESS 312 DOOLIE ROAD MOORESVILLE NC 28115 PHONE: Business Home 660-5494

LOCATION US 70 WEST, TL EUFOLA ROAD, TR BARBARY DRIVE, 3RD LOT ON RIGHT PAST COPPER CREEK DRIVE

SUBDIVISION LANSDOWNE BLOCK / SECTION LOT 34 LOT AREA 0.72 ACRE SITE CLASS. P-S DESIGN FLOW 360 L.T.A.R. 0.30 GPD/FT²

Septic Tank: 1000 Gallons; STB 1012 Date 5-18-98
Pump Tank: Gallons; PT Date
Pump Make: Model Serial No.
Nitrification Field: No Fields 1 Square Feet EQ. TO 1200 Linear Feet 300+
No Lines FIVE Trench Width 36" Max Trench Bottom Depth 36"

☑ New System ☐ Repair System Type: I, II, III, IV, V, VI
System Description: 25% REDUCTION SYSTEM
Repair System Description: 25% REDUCTION PUMP
Maintenance Agreement Required: ☐ Yes ☑ No
~~Gravel~~ Depth SAND 6"

☐ House/Mod. Home ☑ Mobile Home ☐ Business ☐ Other
No. Bedrooms 3 No. Bathrooms 2 No. Employees


Water Supply: ☐ Individual ☑ Public ☐ Community

☐ Slab ☑ Crawl Space ☐ Basement w/plumbing ☐ Basement wo/plumbing

Comments:/Conditions: ① INSTALL SUBSURFACE INTERCEPT DRAINAGE DITCH AT LOCATION SHOWN BEGINNING 48 INCHES DEEP OUT TO DAYLIGHT ② INSTALL 25% REDUCTION SYSTEM USING FIFTY CHAMBERS OR THIRTY H.D.S. SECTIONS

Comments:/Conditions: Lines & Tank checked

INITIAL SITE SKETCH SCALE: 1" = 50'

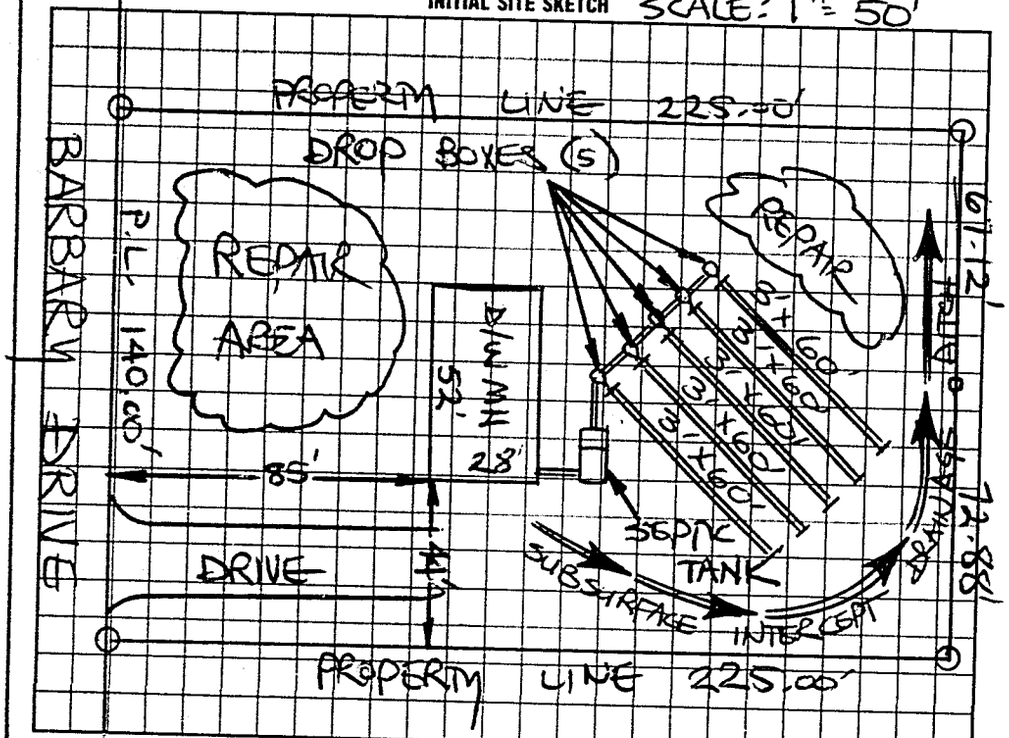

AS BUILT SKETCH

SYSTEM INSTALLED ACCORDING TO INITIAL SITE SKETCH

I understand that this permit can be suspended or revoked if any false information is supplied toward securing the permit/any unauthorized changes are made to the site/any unauthorized changes are made in the installation of the system. Improvement Permit with plat valid without expiration. Improvement Permit with site plan valid for sixty months. Authorization to Construct is valid for a period equal to that of Improvement Permit – not to exceed sixty months.

Signed: Tom Starr

Improvement Permit by: STEVE HEDRICK date 10-6-98

Authorization to Construct by: STEVE HEDRICK date 10-3-98

Installed by: A-1 BACKHOE

Operation Permit by: STEVE HEDRICK date 10-30-98

Existing System Inspection by: date

HEALTH DEPT COPY: WHITE INSPECTION COPY (FINAL): GREEN OWNER COPY (FINAL): YELLOW INSPECTION COPY (INITIAL): PINK OWNER COPY (INITIAL): GOLD