IREDELL COUNTY HEALTH DEPARTMENT

STATESVILLE 704-878-5305 MOORESVILLE 704-664-5281

IMPROVEMENT PERMIT / AUTHORIZATION TO CONSTRUCT / OPERATION PERMIT / EXISTING SYSTEM INSPECTION

PERMIT# 087308 PIN# 4702 82 5855 DATE 2/14/01

OWNER OR CONTRACTOR KINGS FOREST, INC. PHONE: Business (704) 532-6625 Home

ADDRESS 5551 MONROE ROAD, CHARLOTTE, NC 28212

LOCATION HWY 70 W (L) OLD MTN. RD, (R) LEWIS FERRY TO STOP (L) ELFOLA RD. (R) BARBARY DR. 2ND FROM END ON (L)

SUBDIVISION LANSDOWNE BLOCK / SECTION LOT 24 LOT AREA .96 Ac. SITE CLASS PS DESIGN FLOW 360GPD L.T.A.R. .35

Septic Tank: 1000 Gallons; STB 794 Date 2-7-01
Pump Tank: Gallons; PT Date
Pump Make: Model Serial No
Nitrification Field: No Fields 1 Square Feet 1028 Linear Feet 345
No Lines 3 Trench Width 3' Max Trench Bottom Depth 24"

~~New~~ System ☐ Repair System Type: I (II) III IV V VI
System Description: CONVENTIONAL
Repair System Description: SAME
Maintenance Agreement Required: ☐ Yes ~~No~~
Gravel Depth
☐ Slab ~~Crawl Space~~ ☐ Basement w/plumbing ☐ Basement wo/plumbing


☐ House/Mod. Home No. Bedrooms 3
~~Mobile Home~~ No. Bathrooms 2
☐ Business No. Employees
☐ Other

Water Supply: ☐ Individual ~~Public~~ ☐ Community


Comments/Conditions: (1) NO CUTTING OR FILLING OVER DRAINFIELD/REPAIR AREAS (2) KEEP ALL DRAINS AWAY FROM DRAINFIELD/REPAIR AREAS (3) MAINTAIN SETBACKS (4) INSTALL DRAINLINES UNIFORM AND ON CONTOUR

Comments/Conditions:
- Septic Tank Marker Installed
- Zabel Filter Installed

INITIAL SITE SKETCH

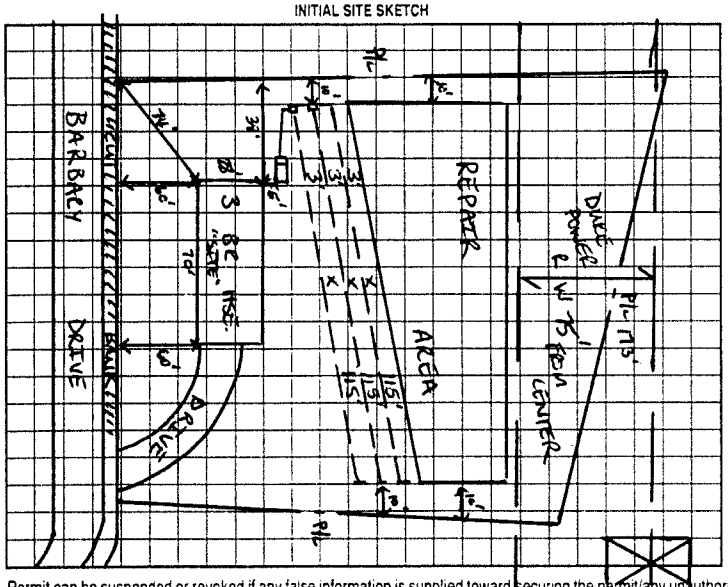

AS BUILT SKETCH

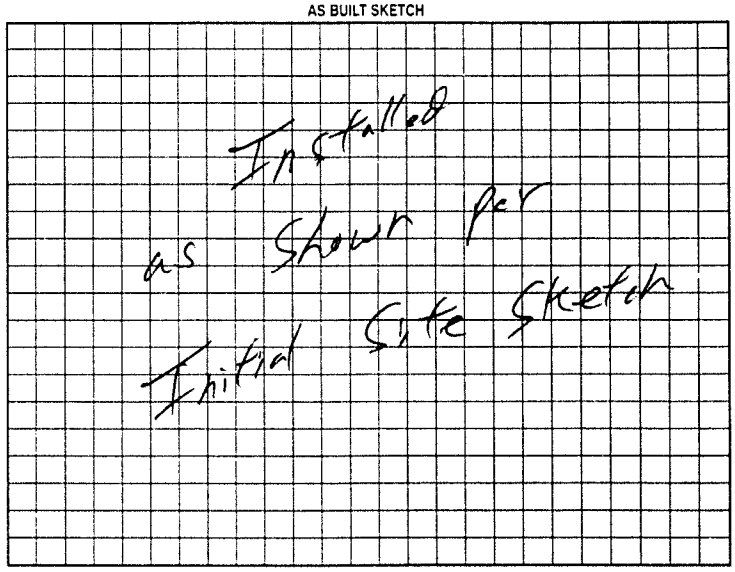

Permit can be suspended or revoked if any false information is supplied toward securing the permit/any unauthorized changes are made to the site/any unauthorized changes are made in the installation of the system. Improvement Permit with plat valid without expiration. Improvement Permit with site plan valid for sixty months. Authorization to Construct is valid for a period equal to that of Improvement Permit – not to exceed sixty months.

~~Signed~~: Shane Bohde date 2-15-01 Installed by: Marty Tucker

Improvement Permit by: Tracy Shinn date 2/14/01 Operation Permit by: William O. Johnson date 6/8/01

Authorization to Construct by: Tracy Shinn date 2/14/01 Existing System Inspection by: date

HEALTH DEPT. COPY WHITE OWNER COPY (FINAL) YELLOW OWNER COPY (INITIAL) PINK