IREDELL COUNTY HEALTH DEPARTMENT

STATESVILLE 704-878-5305 MOORESVILLE 704-664-5281

IMPROVEMENT PERMIT / AUTHORIZATION TO CONSTRUCT / OPERATION PERMIT / EXISTING SYSTEM INSPECTION

PERMIT# 79894 PIN# 4702 83 0445 DATE 4/21/5.99

OWNER OR CONTRACTOR Roger White PHONE: Business _____ Home 704 664 5334

ADDRESS PO Box 55 Mooresville NC

LOCATION Buffalo Shoals (R) Exila (L) Barbary (Lansdowne) (D) Coffin Cr Property on Right

SUBDIVISION Lansdowne BLOCK / SECTION _____ LOT #1 LOT AREA 1.85Ac SITE CLASS FS DESIGN FLOW 480 L.T.A.R. .3

Septic Tank: 1000 Gallons; STB 744 Date 2/18/99
Pump Tank: _____ Gallons; PT _____ Date _____
Pump Make: _____ Model _____ Serial No. _____
Nitrification Field: No Fields 1 Square Feet 1600 Linear Feet 400 -5%
No Lines 5 Trench Width 36" Max Trench Bottom Depth 36" Gravel Depth 6" Sand

☒ New System ☐ Repair System Type: I. II. III. IV. V. VI
System Description: 25% Reduction
Repair System Description: LPP / Pump
Maintenance Agreement Required: ☐ Yes ☒ No

☐ House/Mod. Home No. Bedrooms 4
☒ Mobile Home 4W No. Bathrooms 2
☐ Business No. Employees ____
☐ Other _____


☐ Slab ☒ Crawl Space ☐ Basement w/plumbing ☐ Basement wo/plumbing

Water Supply: ☐ Individual ☒ Public ☐ Community


Comments/Conditions: 67 Chambers or 40 HDS Sections
Bring H2O Line up driveway side
Lines on Contour, 5 Dist Boxes

Comments/Conditions:

INITIAL SITE SKETCH

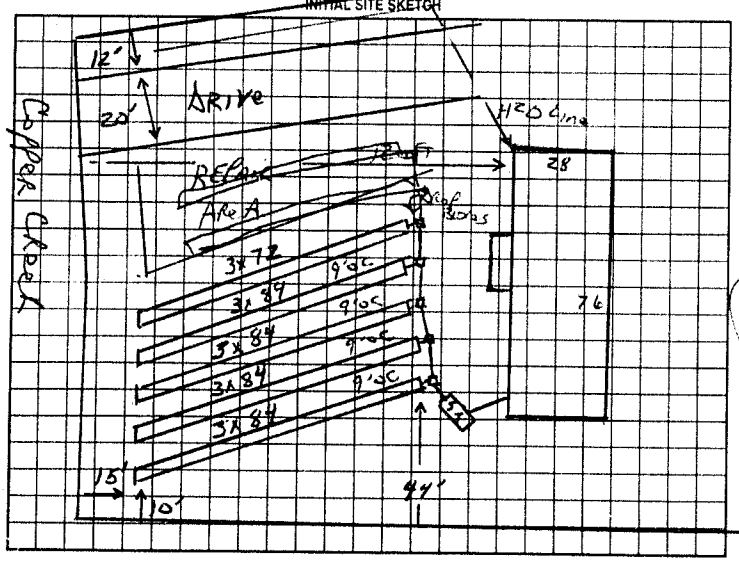

AS BUILT SKETCH

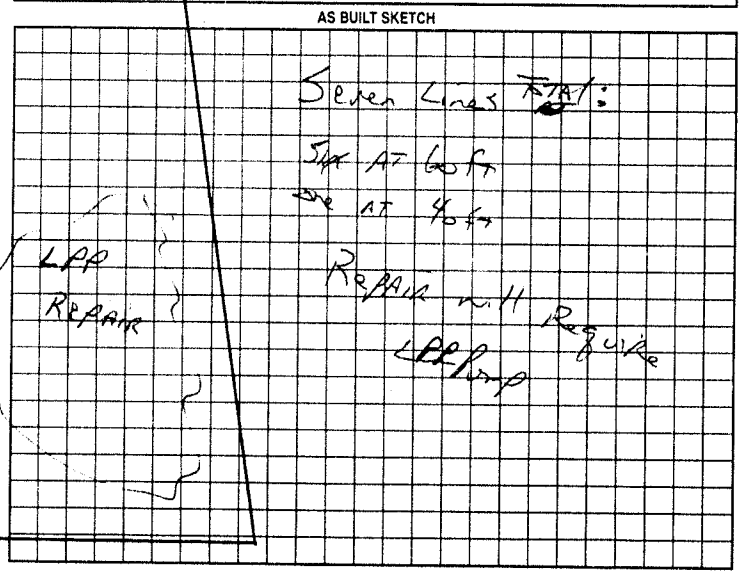

Permit can be suspended or revoked if any false information is supplied toward securing the permit/any unauthorized changes are made to the site/any unauthorized changes are made in the installation of the system. Improvement Permit with plat valid without expiration. Improvement Permit with site plan valid for sixty months. Authorization to Construct is valid for a period equal to that of Improvement Permit – not to exceed sixty months.

Signed: Roger A White date 4-5-99
Improvement Permit by: J. C. Potter date 4-5-99
Authorization to Construct by: J. C. Potter date 4-5-99

Installed by: Coby Co
Operation Permit by: J. C. Potter date 6-9-99
Existing System Inspection by: J. C. Potter date 6-9-99

HEALTH DEPT. COPY: WHITE OWNER COPY (FINAL): YELLOW OWNER COPY (INITIAL): PINK