IREDELL COUNTY HEALTH DEPARTMENT

STATESVILLE 704-878-5305 MOORESVILLE 704-664-5281

IMPROVEMENT PERMIT / AUTHORIZATION TO CONSTRUCT / OPERATION PERMIT / EXISTING SYSTEM INSPECTION

PERMIT# 075057 PIN# 4702 84 2371 (PT) DATE 8-6-98

OWNER OR CONTRACTOR KINGS FOREST, INC PHONE: Business 532-6527 Home

ADDRESS 5551 MONROE ROAD, CHARLOTTE, NC 28212

LOCATION US 70 WEST, TL EUFOLA RD, TR BARBARY DRIVE, TR COPPERCREEK DRIVE, 1ST LOT ON RIGHT

SUBDIVISION LANSDOWNE BLOCK / SECTION LOT 42 LOT AREA 0.98 ACRE SITE CLASS. PS DESIGN FLOW 360 L.T.A.R. 0.30 GPD/FT²

Septic Tank: 1000 Gallons: STB 1017 Date 6-13-98
Pump Tank: Gallons; PT Date
Pump Make: Model Serial No.
Nitrification Field: No Fields 1 Square Feet 1200 Linear Feet 400
No Lines SEVEN Trench Width Max Trench Bottom Depth Gravel Depth

☑ New System ☐ Repair System Type: I, II, III, IV, V, VI
System Description: CONVENTIONAL GRAVITY
Repair System Description: CONV. PUMP
Maintenance Agreement Required: ☐ Yes ☑ No

☐ House/Mod. Home No. Bedrooms 3
☐ Mobile Home No. Bathrooms 2
☐ Business No. Employees
☐ Other


☐ Slab ☑ Crawl Space ☐ Basement w/plumbing ☐ Basement wo/plumbing

Water Supply: ☐ Individual ☑ Public ☐ Community

Comments:/Conditions:

SCALE: 1" = 50'


INITIAL SITE SKETCH

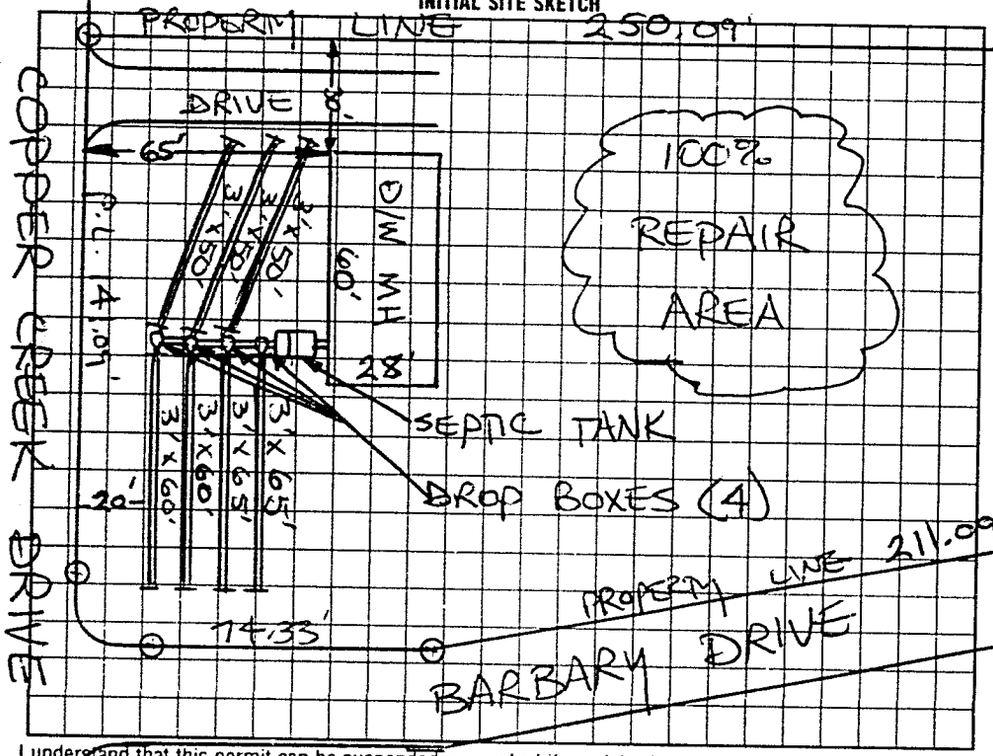

Comments:/Conditions:

* 4 lines Each way due water line Placement

AS BUILT SKETCH

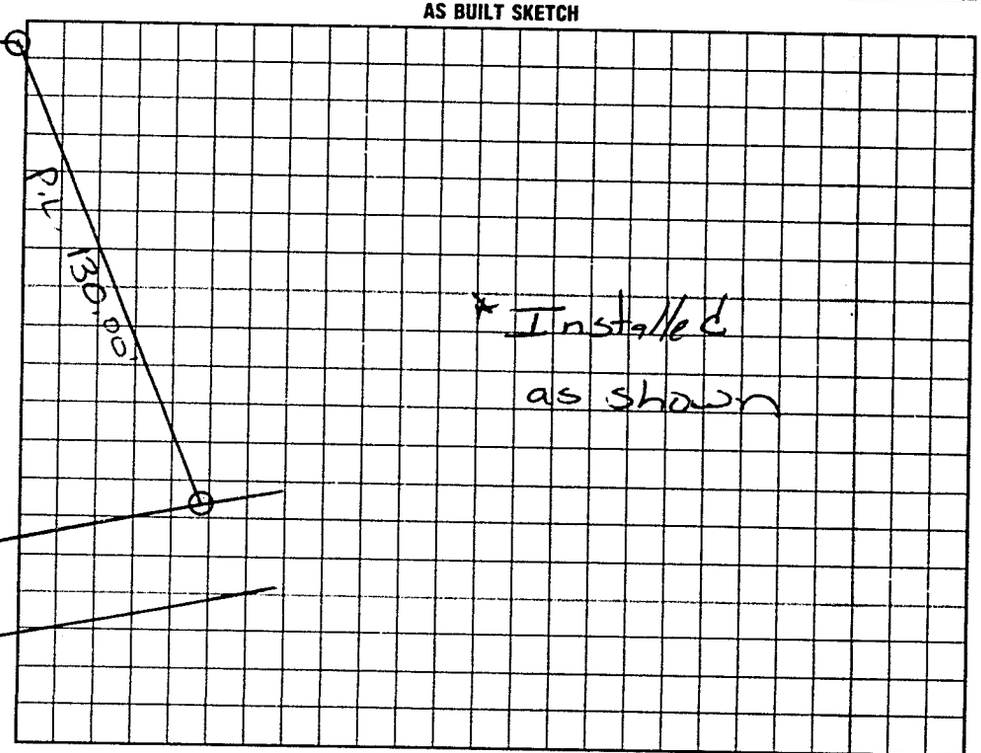

I understand that this permit can be suspended or revoked if any false information is supplied toward securing the permit/any unauthorized changes are made to the site/any unauthorized changes are made in the installation of the system. Improvement Permit with plat valid without expiration. Improvement Permit with site plan valid for sixty months. Authorization to Construct is valid for a period equal to that of Improvement Permit – not to exceed sixty months.

Signed: Dean Honeycutt date 8-10-98
Improvement Permit by: STEVE HEDRICK date 8-6-98
Authorization to Construct by: STEVE HEDRICK date 8-6-98

Installed by: A-1 Backhoe
Operation Permit by: Mat C Ayers date 8-12-98
Existing System Inspection by: date

HEALTH DEPT. COPY: WHITE INSPECTION COPY (FINAL) GREEN OWNER COPY (FINAL) YELLOW INSPECTION COPY (INITIAL) PINK OWNER COPY (INITIAL) GOLD