IREDELL COUNTY HEALTH DEPARTMENT

STATESVILLE 704-878-5305 MOORESVILLE 704-664-5281

IMPROVEMENT PERMIT / AUTHORIZATION TO CONSTRUCT / OPERATION PERMIT / EXISTING SYSTEM INSPECTION

PERMIT# 81708 PIN# 4702832019 DATE July 9 99

OWNER OR CONTRACTOR Kings Forest PHONE: Business 704 532 6527 Home

ADDRESS 5551 Monroe Rd Charlotte, NC

LOCATION Eufula Rd to Barbary Dr Lot on Right next to last Pvt Copper Creek Dr

SUBDIVISION Lansdowne BLOCK / SECTION LOT 36 LOT AREA .75 SITE CLASS P5 DESIGN FLOW 360 L.T.A.R. .03

Septic Tank: 1000 Gallons; STB 794 Date 2-1-99
Pump Tank: Gallons; PT Date
Pump Make: Model Serial No.
Nitrification Field: No Fields 1 Square Feet 1200 Linear Feet 400
No Lines 4 @ 100 Trench Width 36" Max Trench Bottom Depth 36" Gravel Depth 12"

☒ New System ☐ Repair System Type: ☐ I ☒ III, IV, V, VI
System Description: Conv Gravity
Repair System Description: Same / 25% Reduction Pulsed
Maintenance Agreement Required: ☐ Yes ☒ No

☐ House/Mod. Home No. Bedrooms 3
☒ Mobile Home No. Bathrooms 2
☐ Business No. Employees
☐ Other


☐ Slab ☒ Crawl Space ☐ Basement w/plumbing ☐ Basement wo/plumbing

Water Supply: ☐ Individual ☒ Public ☐ Community


Comments/Conditions: Install Lines on Contour
May use 4 Drop Boxes or A Distribution box

Comments/Conditions

INITIAL SITE SKETCH PL 226'

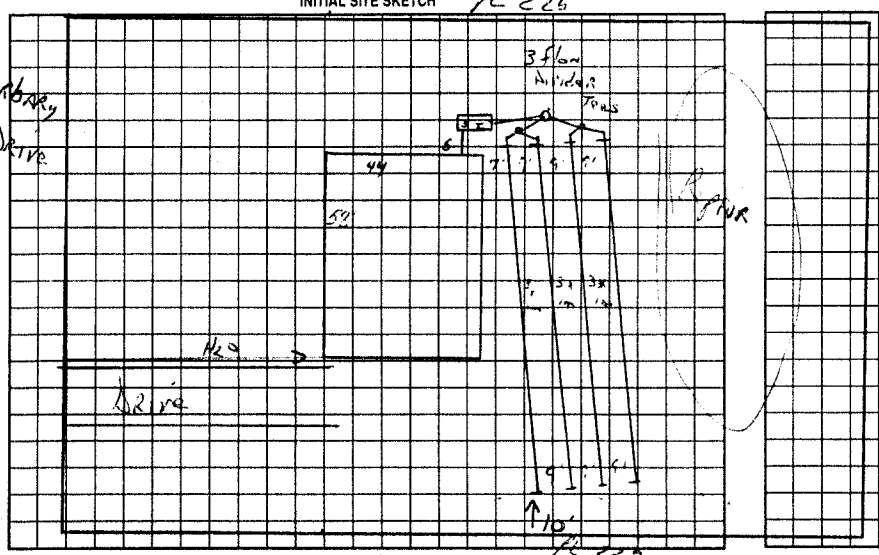

AS BUILT SKETCH

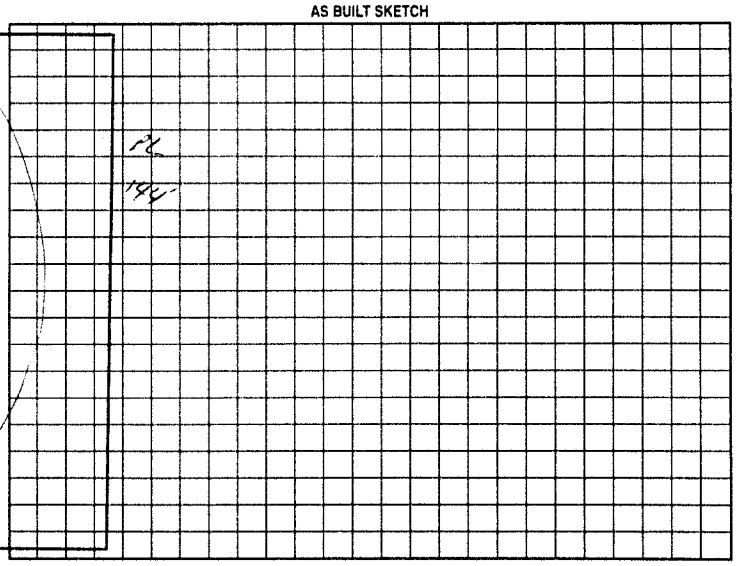

Permit can be suspended or revoked if any false information is supplied toward securing the permit/any unauthorized changes are made to the site/any unauthorized changes are made in the installation of the system. Improvement Permit with plat valid without expiration. Improvement Permit with site plan valid for sixty months. Authorization to Construct is valid for a period equal to that of Improvement Permit – not to exceed sixty months.

Signed: date 7-14-99 Installed by: Dellinger Grading

Improvement Permit by: date 7-9-99 Operation Permit by: date 7-27-99

Authorization to Construct by: date 7-9-99 Existing System Inspection by: date

HEALTH DEPT. COPY: WHITE OWNER COPY (FINAL): YELLOW OWNER COPY (INITIAL): PINK