IREDELL COUNTY HEALTH DEPARTMENT

STATESVILLE 704-878-5305 MOORESVILLE 704-664-5281

IMPROVEMENT PERMIT / AUTHORIZATION TO CONSTRUCT / OPERATION PERMIT / EXISTING SYSTEM INSPECTION

PERMIT# 78440 PIN# 4702833906

OWNER OR CONTRACTOR Felma Norman PHONE: Business _____ Home 5859296 DATE 1-5-99

ADDRESS _____

LOCATION Eufola Rd 203 Dinkins Farm Rd Turn Barbary on left 1/4 mi

SUBDIVISION Landstowne BLOCK / SECTION _____ LOT 16 LOT AREA 1.02 acres SITE CLASS. PS DESIGN FLOW 360 L.T.A.R. 1.15

Septic Tank: 1000 Gallons; STB 786 Date 4-21-99

Pump Tank: _____ Gallons; PT _____ Date _____

Pump Make: _____ Model _____ Serial No. _____

Nitrification Field: No Fields 1 Square Feet 1290 Linear Feet 430

No Lines 5 Trench Width 36" Max Trench Bottom Depth 36" Gravel Depth 12"

☑ New System ☐ Repair System Type: I II III IV V VI

System Description: Conv. Gravity

Repair System Description: " "

Maintenance Agreement Required: ☐ Yes ☑ No

☐ House/Mod. Home No. Bedrooms 3

☑ Mobile Home No. Bathrooms 2

☐ Business No. Employees _____

☐ Other _____


☐ Slab ☑ Crawl Space ☐ Basement w/plumbing ☐ Basement wo/plumbing

Water Supply: ☐ Individual ☑ Public ☐ Community


Comments/Conditions:

Comments/Conditions

INITIAL SITE SKETCH

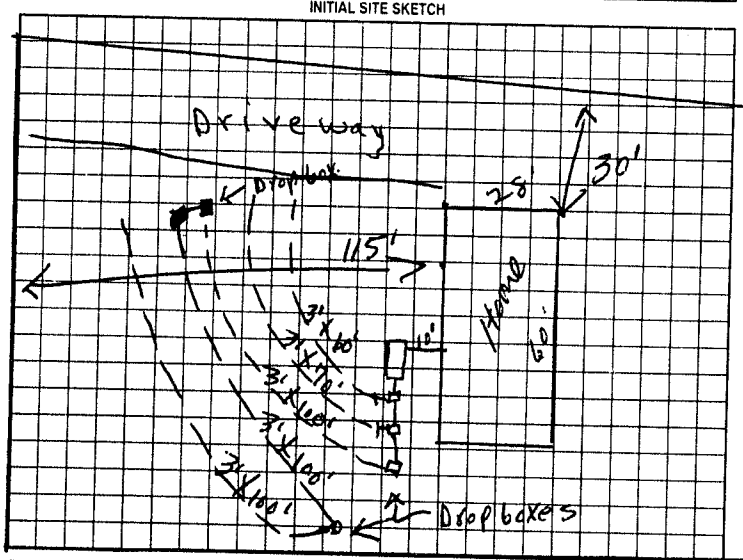

AS BUILT SKETCH

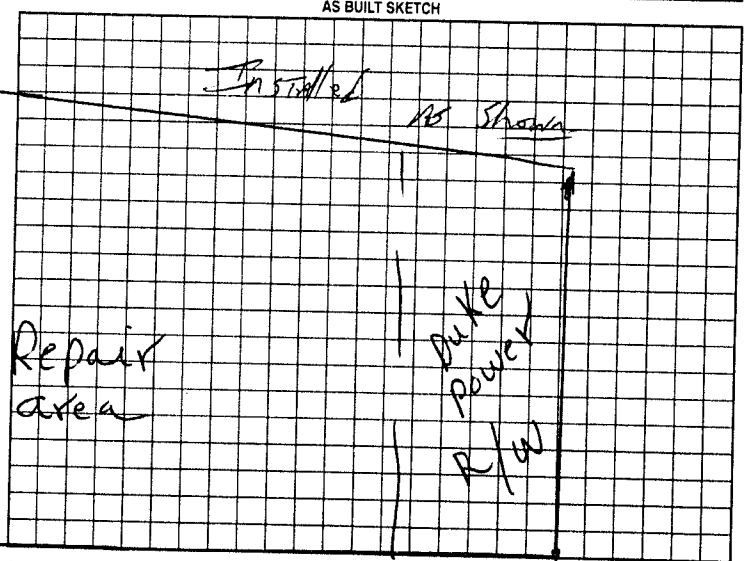

Permit can be suspended or revoked if any false information is supplied toward securing the permit/any unauthorized changes are made to the site/any unauthorized changes are made in the installation of the system. Improvement Permit with plat valid without expiration. Improvement Permit with site plan valid for sixty months. Authorization to Construct is valid for a period equal to that of Improvement Permit – not to exceed sixty months.

Signed: [signature] date _____ Installed by: Leatherman

Improvement Permit by: R. C. Moore date 1-5-99 Operation Permit by: JC Potter date 6.11.99

Authorization to Construct by: R. C. Moore date 1-5-99 Existing System Inspection by: _____ date _____

HEALTH DEPT COPY: WHITE OWNER COPY (FINAL): YELLOW OWNER COPY (INITIAL): PINK