IREDELL COUNTY HEALTH DEPARTMENT

Statesville Office (704) 878-5305 Mooresville Office (704) 660-3625 PERMIT # 209765

IMPROVEMENT PERMIT / AUTHORIZATION TO CONSTRUCT / OPERATION PERMIT / EXISTING SYSTEM

PIN # 4702835051

APPLICANT: William Loaf APPLICANT ADDRESS: 259 Barbary Dr

SITE ADDRESS: 259 Barbary Dr. PHONE: 803-269-0912 ALT. PHONE: N/A


SITE DIRECTIONS: Hwy 70W TL Eufola Rd TR Barbary Dr.

SUBDIVISION: Lansdowne SECTION: M4 LOT # 23 LOT AREA: 0.96 acres DESIGN FLOW: 480 L.T.A.R.: Existing


Septic Tank: Existing (gal)	STB	Date	☐ New System ☐ Repair ☐ Expansion	System Type: I (II) III IV V VI	☑ Residence	No. Bedrooms: 4	Water Supply: ☐ Private
Pump Tank (gal)	PT	Date	System Description: Existing		☐ Business	No. Persons: 8	☑ Public
Pump Make	Model	Serial #	Repair System Description:		☐ Other	No. Employees	☐ Community
# Nitrification Fields: Ex	# Lines: Ex	Linear Ft: Ex	Maintenance Agreement Required:	☐ YES ☑ NO	☐ Slab	☑ Crawl Space	
Trench Width: Ex	Max. Trench Bottom Depth: Ex	Gravel Depth: Ex	☑ GRAVITY	☐ PRESSURE	☐ Basement w/plumbing	☐ Basement w/o plumbing	

Comments / Conditions: The Purpose of this permit was to approve setbacks from existing deck to all components of septic system. All points of Decks foundation are a minimum of 5' from any component of septic system. The Decks foundation has been cantilevered to meet the 5' setback to septic system.

INITIAL SITE SKETCH

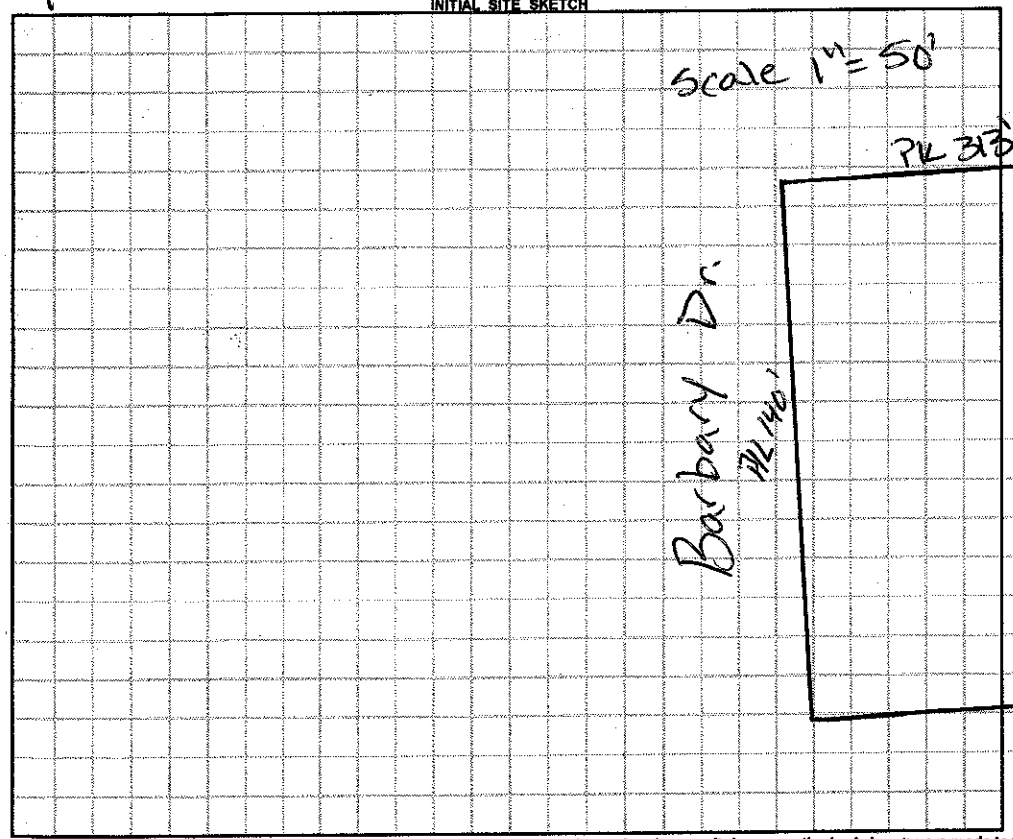

AS BUILT SKETCH

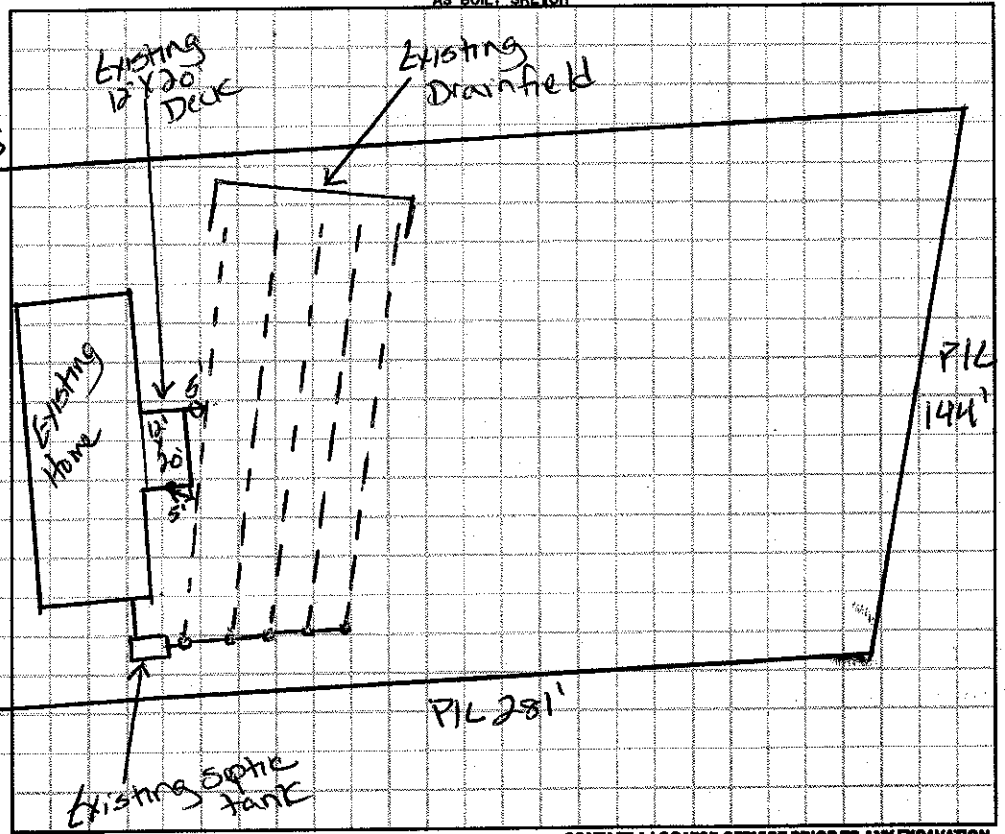

Permit can be suspended or revoked if any false information is supplied toward securing the permit / any unauthorized changes are made to the site / any unauthorized changes are made in the installation of the system. **CONTACT A LOCATOR SERVICE PRIOR TO ANY EXCAVATION**

☐ **IMPROVEMENT PERMIT** *with plat valid without expiration.* ☐ **IMPROVEMENT PERMIT** *with site plan valid for 60 mos.* ☐ **AUTHORIZATION TO CONSTRUCT** *valid for period equal to IMPROVEMENT PERMIT--not to exceed 60 mo.*

Owner / Applicant Signature: Joseph E. LeFarge Date: 5/13/15 Installed by:

IMPROVEMENT PERMIT by: Date: OPERATION PERMIT by: Date:

AUTHORIZATION TO CONSTRUCT by: Date: Existing System Inspected by: Justin Henderson Date: 5-13-15

Health Dept. Copy - WHITE Applicant (Final Approval) - YELLOW Applicant (Conditional Approval) - PINK