IREDELL COUNTY HEALTH DEPARTMENT

STATESVILLE 704-878-5305 MOORESVILLE 704-664-5281

IMPROVEMENT PERMIT / AUTHORIZATION TO CONSTRUCT / OPERATION PERMIT / EXISTING SYSTEM INSPECTION

PERMIT# 81929 PIN# 4702835154 DATE June 22 99

OWNER OR CONTRACTOR Billy R Powell PHONE: Business 500 460 4399 Home

ADDRESS P.O. Box 2056 Albemarle NC 28002

LOCATION Old Mt Rd (R) Lewis Fork (L) Estes (R) Blackberry on Left

SUBDIVISION Lansdowne BLOCK / SECTION LOT 22 LOT AREA 1.06 Ac. SITE CLASS FS DESIGN FLOW 360 L.T.A.R. .3

Septic Tank: 1000 Gallons; STB 1012 Date 3/2/99
Pump Tank: Gallons; PT Date
Pump Make: Model Serial No.
Nitrification Field: No Fields 1 Square Feet 1200 Linear Feet 400
No Lines 4 @ 100 Trench Width 36" Max Trench Bottom Depth 36" Gravel Depth 12"

☒ New System ☐ Repair System Type: I (II) III IV V VI
System Description: Conv Capacity
Repair System Description: Same 25% Reduction
Maintenance Agreement Required: ☐ Yes ☒ No


☐ House/Mod. Home No. Bedrooms 3
☒ Mobile Home DW No. Bathrooms 2
☐ Business No. Employees
☐ Other
☐ Slab ☒ Crawl Space ☐ Basement w/plumbing ☐ Basement wo/plumbing

Water Supply: ☐ Individual ☒ Public ☐ Community


Comments/Conditions: INSTALL Lines on CONTOUR
4 Drop Boxes or 3 Flow divider Tees

Comments/Conditions:

INITIAL SITE SKETCH

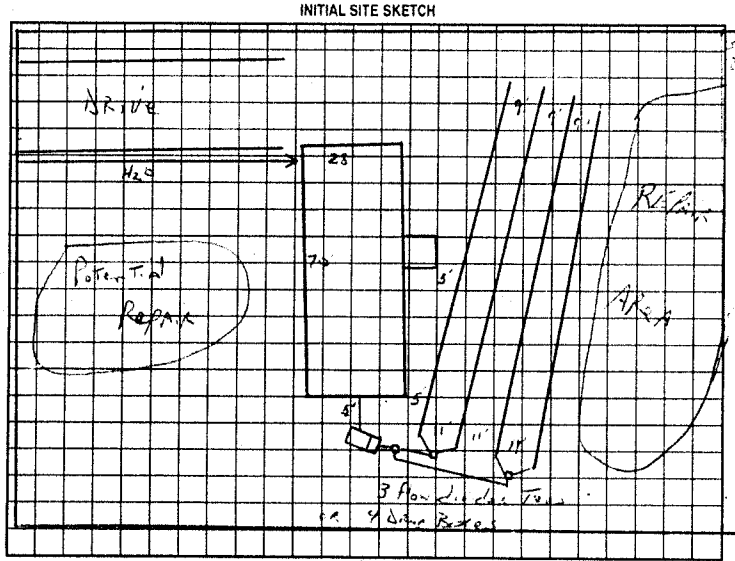

AS BUILT SKETCH

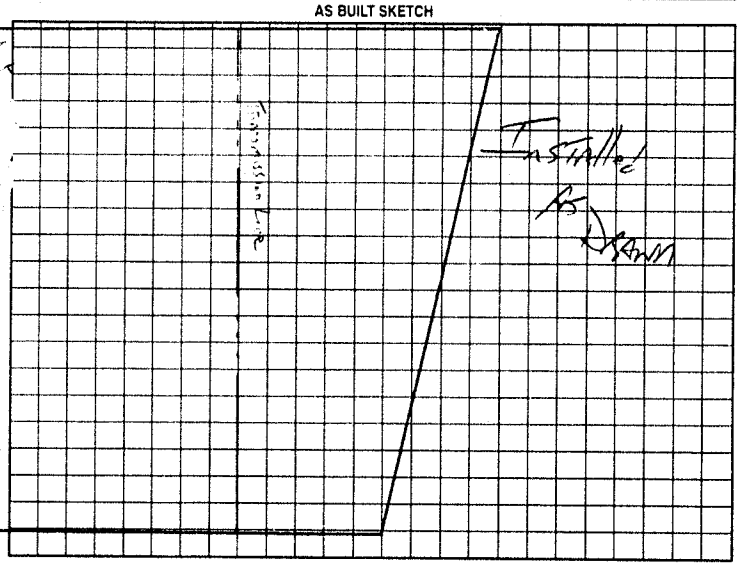

Permit can be suspended or revoked if any false information is supplied toward securing the permit/any unauthorized changes are made to the site/any unauthorized changes are made in the installation of the system. Improvement Permit with plat valid without expiration. Improvement Permit with site plan valid for sixty months. Authorization to Construct is valid for a period equal to that of Improvement Permit – not to exceed sixty months.

Signed: [signature] date 6-24-99

Improvement Permit by: [signature] date 6-22-99

Authorization to Construct by: [signature] date 6-22-99

Installed by: M Blackburn

Operation Permit by: [signature] date 7-26-99

Existing System Inspection by: date

HEALTH DEPT COPY: WHITE OWNER COPY (FINAL): YELLOW OWNER COPY (INITIAL): PINK