IREDELL COUNTY HEALTH DEPARTMENT

STATESVILLE 704-878-5305 MOORESVILLE 704-664-5281

IMPROVEMENT PERMIT / AUTHORIZATION TO CONSTRUCT / OPERATION PERMIT / EXISTING SYSTEM INSPECTION

PERMIT# 79699 PIN# 4702833 6527 DATE 3 23 99

OWNER OR CONTRACTOR Kings Forest Inc PHONE: Business 704 532 6527 Home

ADDRESS 5551 Monroe Rd Charlotte NC

LOCATION Lot 20 Landsdowne

SUBDIVISION Landsdowne BLOCK / SECTION LOT 20 LOT AREA 1.36 SITE CLASS PS DESIGN FLOW 360 L.T.A.R. .3

Septic Tank: 1000 Gallons: STB 1012 Date 2-8-99
Pump Tank: Gallons; PT Date
Pump Make: Model Serial No
Nitrification Field: No Fields 1 Square Feet 1200 Linear Feet 400
No Lines 4 Trench Width 36" Max Trench Bottom Depth 36 Gravel Depth 12"

☑ New System ☐ Repair System Type: I (II) III IV V VI
System Description: CGRAV. Conv.
Repair System Description: Pump to Gravity
Maintenance Agreement Required: ☐ Yes ☑ No
☐ Slab ☑ Crawl Space ☐ Basement w/plumbing ☐ Basement wo/plumbing


☐ House/Mod. Home No. Bedrooms 3
☑ Mobile Home A/W No. Bathrooms 2
☐ Business No. Employees
☐ Other

Water Supply: ☐ Individual ☑ Public ☐ Community


Comments/Conditions: INSTALL LINES ON CONTOUR
4 DROP BOXES

Comments/Conditions: #57 STONE

INITIAL SITE SKETCH

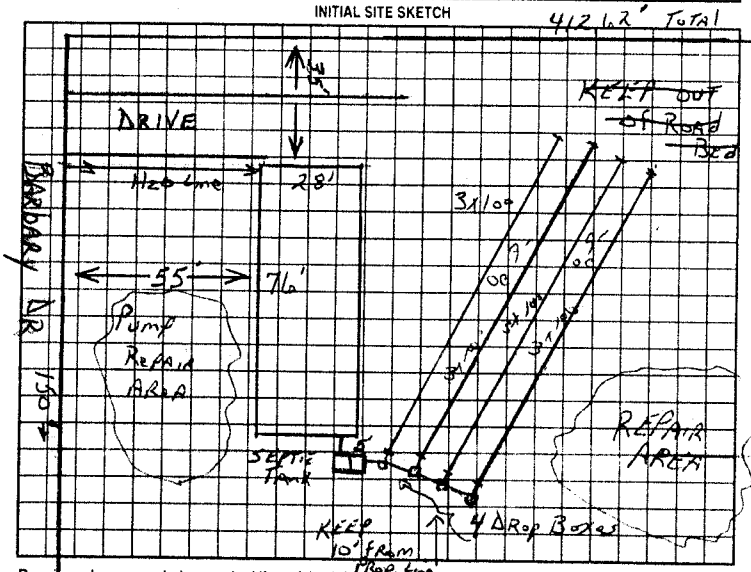

AS BUILT SKETCH

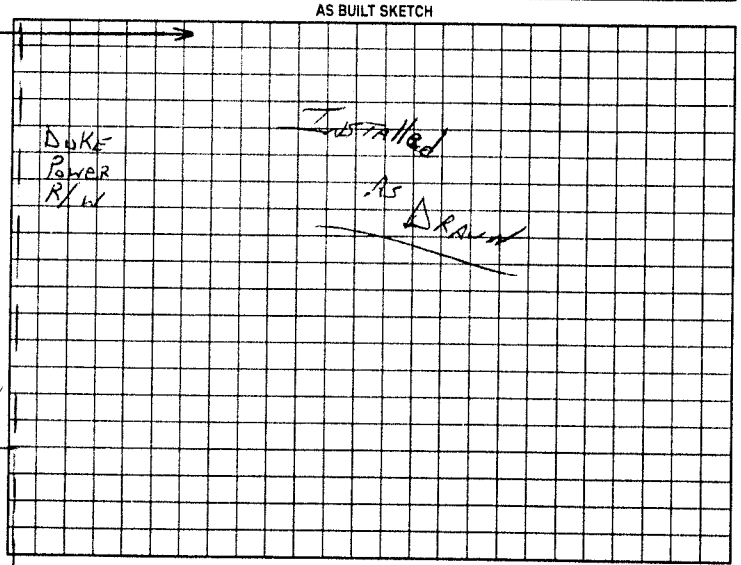

Permit can be suspended or revoked if any false information is supplied toward securing the permit/any unauthorized changes are made to the site/any unauthorized changes are made in the installation of the system. Improvement Permit with plat valid without expiration. Improvement Permit with site plan valid for sixty months. Authorization to Construct is valid for a period equal to that of Improvement Permit – not to exceed sixty months.

Signed: date

Improvement Permit by: C Potter date 3-23-99

Authorization to Construct by: C. Potter date 3 23 99

Installed by: ~~Dr~~ Al Backhoe

Operation Permit by: C Potter date Apr 15 '99

Existing System Inspection by: date

HEALTH DEPT COPY WHITE OWNER COPY (FINAL) YELLOW OWNER COPY (INITIAL) PINK