IREDELL COUNTY HEALTH DEPARTMENT

STATESVILLE 704-878-5305 MOORESVILLE 704-664-5281

IMPROVEMENT PERMIT / AUTHORIZATION TO CONSTRUCT / OPERATION PERMIT / EXISTING SYSTEM INSPECTION

PERMIT# 81612 PIN# 4702835529 DATE June 4 99

OWNER OR CONTRACTOR Freedom Homes PHONE: Business 7045289449 Home

ADDRESS 1018 Charlotte Hwy Troutman

LOCATION 70W (L) Eufola (R) Barbary on Left Lansdowne

SUBDIVISION Lansdowne BLOCK / SECTION LOT 19 LOT AREA 1.65 SITE CLASS. P.S DESIGN FLOW 360 L.T.A.R. 63

Septic Tank: 1000 Gallons; STB 1012 Date 5-21-99
Pump Tank: Gallons; PT Date
Pump Make: Model Serial No.
Nitrification Field: No Fields 1 Square Feet 1200 Linear Feet 400
No Lines 5@80 Trench Width 36" Max Trench Bottom Depth 36" Gravel Depth 12"

☒ New System ☐ Repair System Type: I, (II) III, IV, V, VI
System Description: Conv Gravity
Repair System Description: 25% Reduction Gravity
Maintenance Agreement Required: ☐ Yes ☒ No

☐ House/Mod. Home ☒ Mobile Home DW ☐ Business ☐ Other
No. Bedrooms 3 No. Bathrooms 2 No. Employees


☐ Slab ☒ Crawl Space ☐ Basement w/plumbing ☐ Basement wo/plumbing

Water Supply: ☐ Individual ☒ Public ☐ Community


Comments/Conditions: Install Lines on Contour
Keep Septic Lines 5 Ft from Deck & House

Comments/Conditions:

INITIAL SITE SKETCH

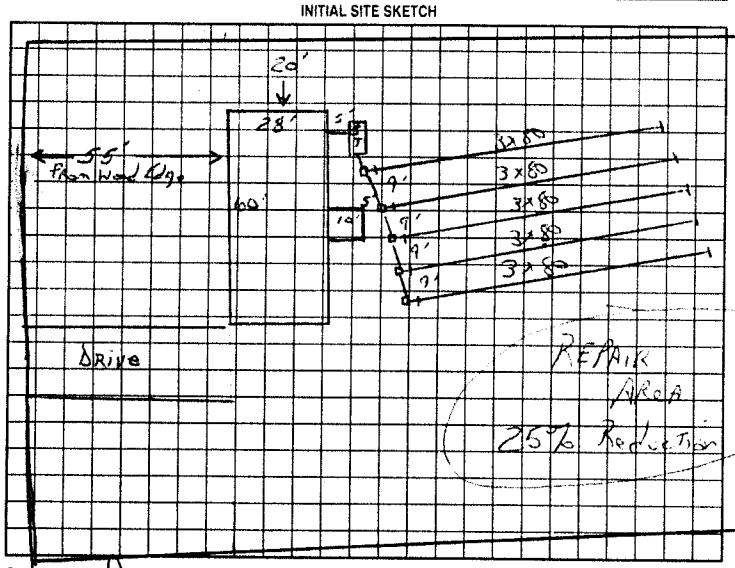

AS BUILT SKETCH

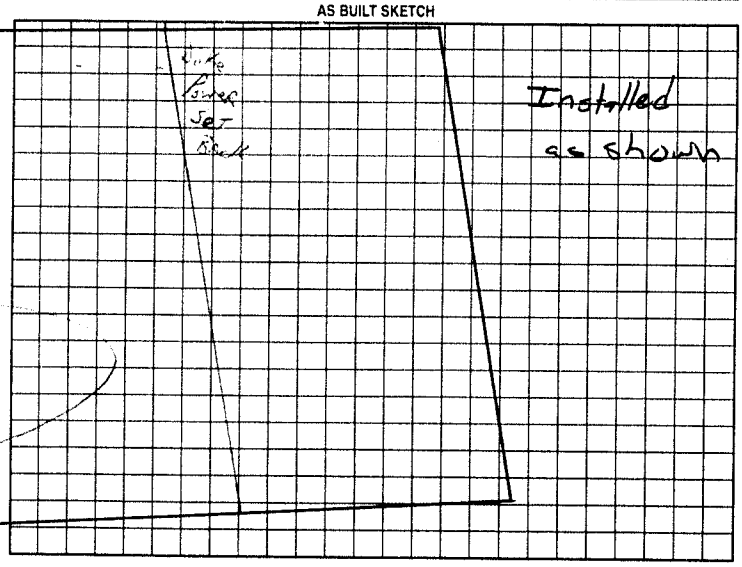

Permit can be suspended or revoked if any false information is supplied toward securing the permit/any unauthorized changes are made to the site/any unauthorized changes are made in the installation of the system. Improvement Permit with plat valid without expiration. Improvement Permit with site plan valid for sixty months. Authorization to Construct is valid for a period equal to that of Improvement Permit – not to exceed sixty months.

Signed: [signature] date 6-8-99

Improvement Permit by: J.C. Potter date 6.4.99

Authorization to Construct by: J.C. Potter date 6.4.99

Installed by: A-1 Backhoe

Operation Permit by: Mark C Outlaw RS date 7-27-99

Existing System Inspection by: date

HEALTH DEPT. COPY: WHITE OWNER COPY (FINAL): YELLOW OWNER COPY (INITIAL): PINK