# IREDELL COUNTY HEALTH DEPARTMENT

STATESVILLE 704-878-5305 MOORESVILLE 704-664-5281

## IMPROVEMENT PERMIT / AUTHORIZATION TO CONSTRUCT / OPERATION PERMIT / EXISTING SYSTEM INSPECTION

PERMIT# 075051 PIN# 4702 84 2371 (PT) DATE 2-8-99

OWNER OR CONTRACTOR KINGS FOREST, INC PHONE: Business 532-6527 Home

ADDRESS 5551 MONROE ROAD, CHARLOTTE, NC 28212

LOCATION US 70 WEST, TL EUFOLA ROAD, TR BARBARY DRIVE, 18TH LOT ON LEFT

SUBDIVISION LANSDOWNE BLOCK / SECTION LOT 18 LOT AREA 1.83 ACRES SITE CLASS PS DESIGN FLOW 360 L.T.A.R. 0.30 GPD/FT²

Septic Tank: 1000 Gallons; STB 1012 Date 11 28 98
Pump Tank: Gallons; PT Date
Pump Make: Model Serial No.
Nitrification Field: No Fields 1 Square Feet EQ TO 1200 Linear Feet 300±
No Lines ~~FIVE~~ SIX Trench Width 36" Max Trench Bottom Depth 30" Gravel Depth 12"

☑ New System ☐ Repair System Type: I, II, (III), IV, V, VI
System Description: 25% REDUCTION GRAVITY
Repair System Description: LPP & 25% RED. GRAV.
Maintenance Agreement Required: ☐ Yes ☑ No
☐ Slab ☑ Crawl Space ☐ Basement w/plumbing ☐ Basement wo/plumbing

☐ House/Mod. Home No. Bedrooms 3
☑ Mobile Home No. Bathrooms 2
☐ Business No. Employees
☐ Other


Water Supply: ☐ Individual ☑ Public ☐ Community

Comments:/Conditions: INSTALL FIFTY (50) CHAMBERS OR THIRTY-SIX (36) HDS SECTIONS NO DEEPER THAN 30"


Comments:/Conditions: 7.5"x60" FILTER INSTALLED AT OUTLET OF SEPTIC TANK

SCALE: 1"=50'

INITIAL SITE SKETCH

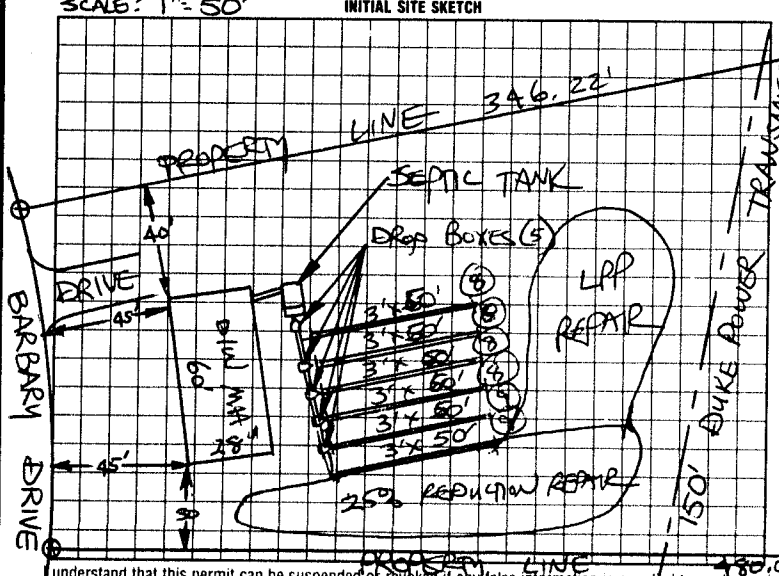


AS BUILT SKETCH

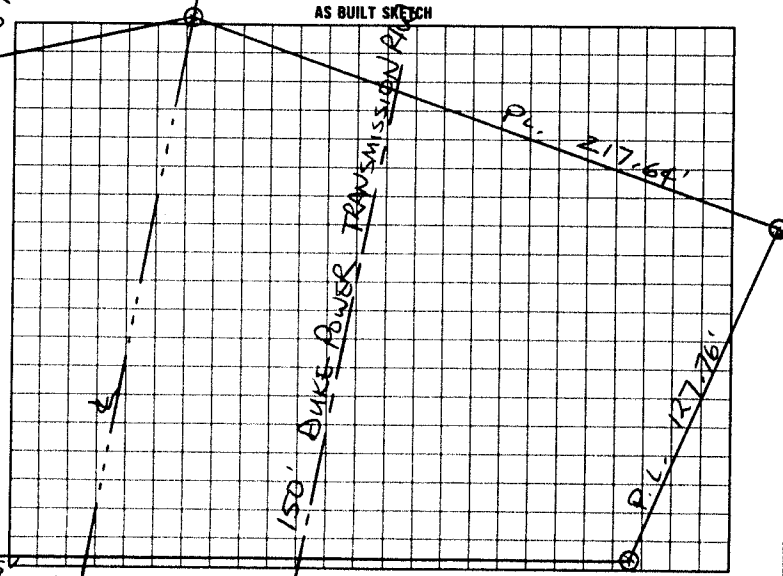


I understand that this permit can be suspended or revoked if any false information is supplied toward securing the permit/any unauthorized changes are made to the site/any unauthorized changes are made in the installation of the system. Improvement Permit with plat valid without expiration. Improvement Permit with site plan valid for sixty months. Authorization to Construct is valid for a period equal to that of Improvement Permit – not to exceed sixty months.

Signed: x Dennis Gallifer date

Improvement Permit by: STEVE HEDRICK date 2-8-99

Authorization to Construct by: STEVE HEDRICK date 2-8-99

Installed by: A-1 BACKHOE

Operation Permit by: STEVE HEDRICK date 2-8-99

Existing System Inspection by: date

HEALTH DEPT. COPY: WHITE INSPECTION COPY (FINAL): GREEN OWNER COPY (FINAL) YELLOW INSPECTION COPY (INITIAL) PINK OWNER COPY (INITIAL) GOLD