IREDELL COUNTY HEALTH DEPARTMENT

STATESVILLE 704-878-5305 MOORESVILLE 704-664-5281

IMPROVEMENT PERMIT / AUTHORIZATION TO CONSTRUCT / OPERATION PERMIT / EXISTING SYSTEM INSPECTION

PERMIT# 81021 PIN# 4702841886 DATE 6-30-99

OWNER OR CONTRACTOR Kings Forest Inc PHONE: Business 5326625 Home

ADDRESS Monroe Rt Charlotte N.C.

LOCATION Hwy 70 west TL ome TR Lewis Ferry TL Eufola TR Barlow 1500' left

SUBDIVISION Bantztown BLOCK / SECTION LOT 9+10 LOT AREA 2.19 acres SITE CLASS PS DESIGN FLOW 360 L.T.A.R. .3

Septic Tank: 1000 Gallons; STB 794 Date 4-16-99 New System Repair System Type: I. II. III IV. V. VI

Pump Tank: Gallons; PT Date System Description: 8" Large Diameter Pipe

Pump Make: Model Serial No. Repair System Description: IL IL IL

Nitrification Field: No Fields 1 Square Feet 1080 Linear Feet 540 Maintenance Agreement Required: Yes No

No Lines 6 Trench Width 24" Max Trench Bottom Depth 18" Gravel Depth N/A Slab Crawl Space Basement w/plumbing Basement wo/plumbing

House/Mod. Home No. Bedrooms 3

Mobile Home No. Bathrooms 2


Business No. Employees

Other

Water Supply: Individual Public Community


Comments/Conditions: 324

INITIAL SITE SKETCH

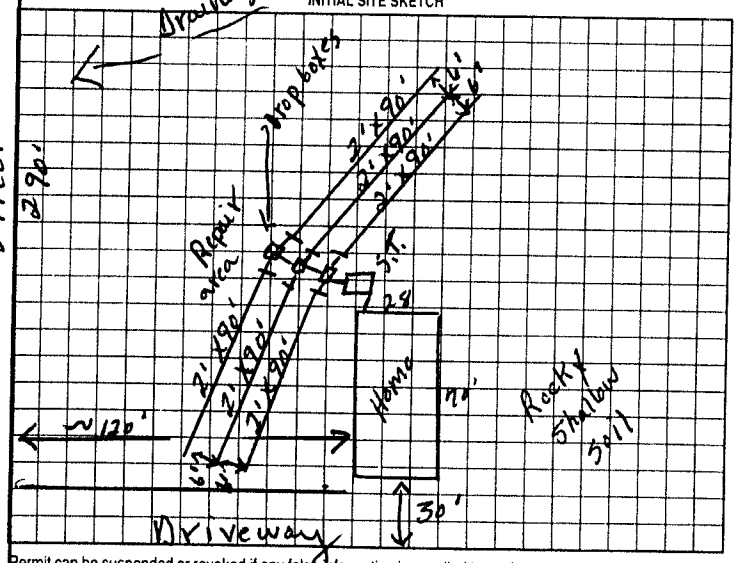

Comments/Conditions: very Important To keep lines shallow + on contour. The pipe must be placed on The floor of The Trench + encased in Sand with a 6" cap of of Native soil.

AS BUILT SKETCH

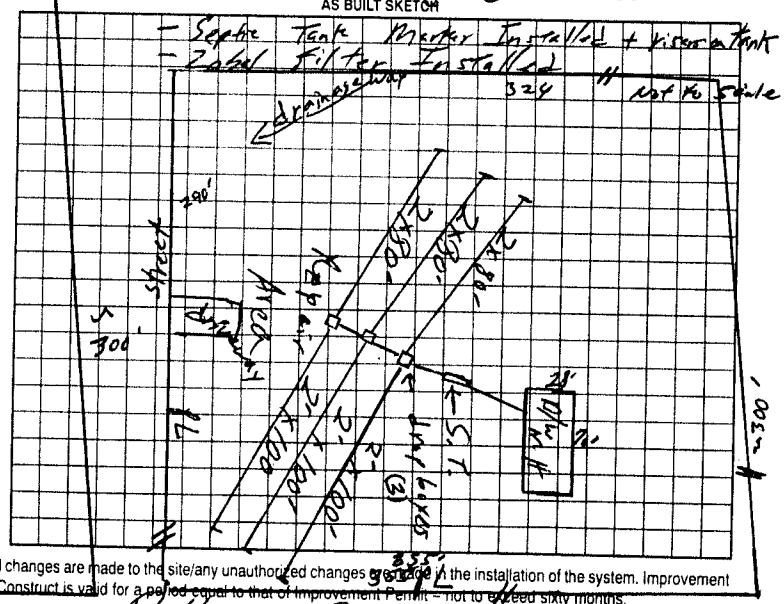

Permit can be suspended or revoked if any false information is supplied toward securing the permit/any unauthorized changes are made to the site/any unauthorized changes are made in the installation of the system. Improvement Permit with plat valid without expiration. Improvement Permit with site plan valid for sixty months. Authorization to Construct is valid for a period equal to that of Improvement Permit - not to exceed sixty months.

Signed: [signature] date 7-8-99 Installed by: Dellinger Grading

Improvement Permit by: P. C. moore date 6-30-99 Operation Permit by: William O. Johnson date 8/2/01

Authorization to Construct by: P. C. moore date 6-30-99 Existing System Inspection by: date

HEALTH DEPT. COPY: WHITE OWNER COPY (FINAL): YELLOW OWNER COPY (INITIAL): PINK

Important * do Not drive over Septic System Nitrification Lines.