IREDELL COUNTY HEALTH DEPARTMENT

STATESVILLE 704-878-5305 MOORESVILLE 704-664-5281

IMPROVEMENT PERMIT / AUTHORIZATION TO CONSTRUCT / OPERATION PERMIT / EXISTING SYSTEM INSPECTION

PERMIT# 81075 PIN# 4702842067 DATE May 27, 99

OWNER OR CONTRACTOR Kings Forest PHONE: Business 704 532 6625 Home

ADDRESS 5551 Monroe Rd Charlotte NC

LOCATION On Left Barbary Dr off Eufola off ~~74~~ 1ST ± E Lewis Fossy off Old NT Road

SUBDIVISION Lansdowne BLOCK / SECTION LOT 15 LOT AREA 1.56 SITE CLASS B DESIGN FLOW 360 L.T.A.R. .3

Septic Tank: 1000 Gallons: STB 1012 Date 4-26-99

Pump Tank: Gallons: PT Date

Pump Make: Model Serial No.

Nitrification Field: No Fields 1 Square Feet 1200 Linear Feet 400

No Lines 4 @ 100 Trench Width 36 Max Trench Bottom Depth 18

☐ New System ☐ Repair System Type: I II III IV V VI

System Description: Conv. Gravity Sanitas

Repair System Description: 25% Reduction

Maintenance Agreement Required: ☐ Yes ☒ No

Gravel Depth 12" ☐ Slab ☒ Crawl Space ☐ Basement w/plumbing ☐ Basement wo/plumbing

☐ House/Mod. Home No. Bedrooms 3

☒ Mobile Home DW No. Bathrooms 2

☐ Business No. Employees


☐ Other

Water Supply: ☐ Individual ☒ Public ☐ Community


Comments/Conditions: 3 Flow Divider Tees
Install Lines on Contour

Comments/Conditions

INITIAL SITE SKETCH

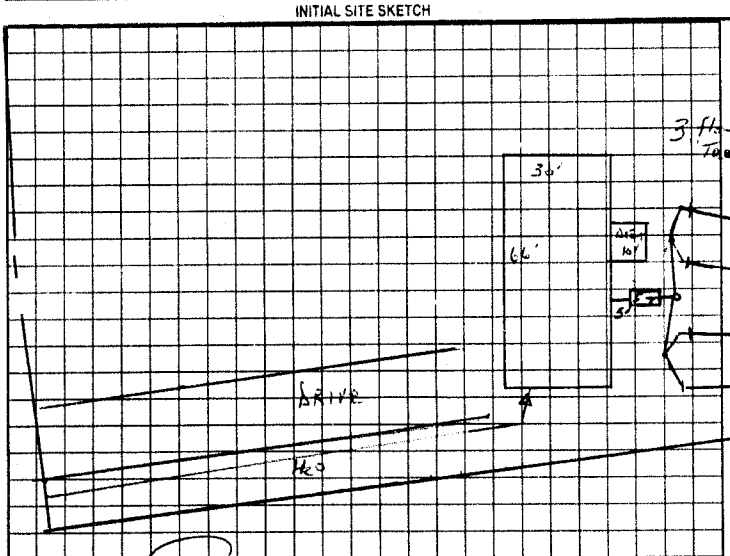

AS BUILT SKETCH

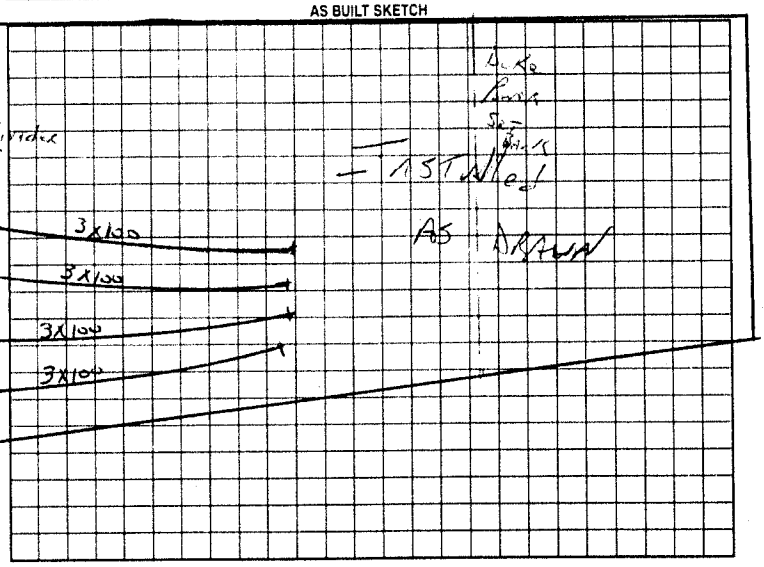

Permit can be suspended or revoked if any false information is supplied toward securing the permit/any unauthorized changes are made to the site/any unauthorized changes are made in the installation of the system. Improvement Permit with plat valid without expiration. Improvement Permit with site plan valid for sixty months. Authorization to Construct is valid for a period equal to that of Improvement Permit – not to exceed sixty months.

Signed: [signature] date May 28, 1999 Installed by: Al Bucklin

Improvement Permit by: Joe Potter date May 27 99 Operation Permit by: Joe Potter date 6 10 99

Authorization to Construct by: Joe Potter date May 27 99 Existing System Inspection by: date

HEALTH DEPT. COPY: WHITE OWNER COPY (FINAL): YELLOW OWNER COPY (INITIAL): PINK