IREDELL COUNTY HEALTH DEPARTMENT

STATESVILLE 704-878-5305 MOORESVILLE 704-664-5281

IMPROVEMENT PERMIT / AUTHORIZATION TO CONSTRUCT / OPERATION PERMIT / EXISTING SYSTEM INSPECTION

PERMIT# 83435 PIN# 4702842148 DATE Sept 16 99

OWNER OR CONTRACTOR Melissa Eades PHONE: Business 872-9820 Home

ADDRESS 108 Apricot Ln Statesville NC

LOCATION Buffalo Shoals S (R) E.Gla (L) Barberry on Left

SUBDIVISION Lansdowne BLOCK / SECTION LOT 14 LOT AREA 1.04ac SITE CLASS PS DESIGN FLOW 360 L.T.A.R. .3

Septic Tank: 1000 Gallons; STB 786 Date 7-1999
Pump Tank: Gallons; PT Date
Pump Make: Model Serial No.
Nitrification Field: No Fields 1 Square Feet 1200 Linear Feet 300
No Lines 4 Trench Width 36" Max Trench Bottom Depth 24" Gravel Depth

☑ New System ☐ Repair System Type: I, II, (III), IV, V, VI
System Description: 25% Reduction Gravity
Repair System Description: 25-50% Pump Possible
Maintenance Agreement Required: ☐ Yes ☑ No

☐ House/Mod. Home ☑ Mobile Home SW ☐ Business ☐ Other
No. Bedrooms 3 No. Bathrooms 2 No. Employees


Water Supply: ☐ Individual ☑ Public ☐ Community

☐ Slab ☑ Crawl Space ☐ Basement w/plumbing ☐ Basement wo/plumbing


Comments/Conditions: Install on Contour
30 HDS Sections Recommended Due To Contours
Keep H2O Line off septic system

Comments/Conditions:

INITIAL SITE SKETCH

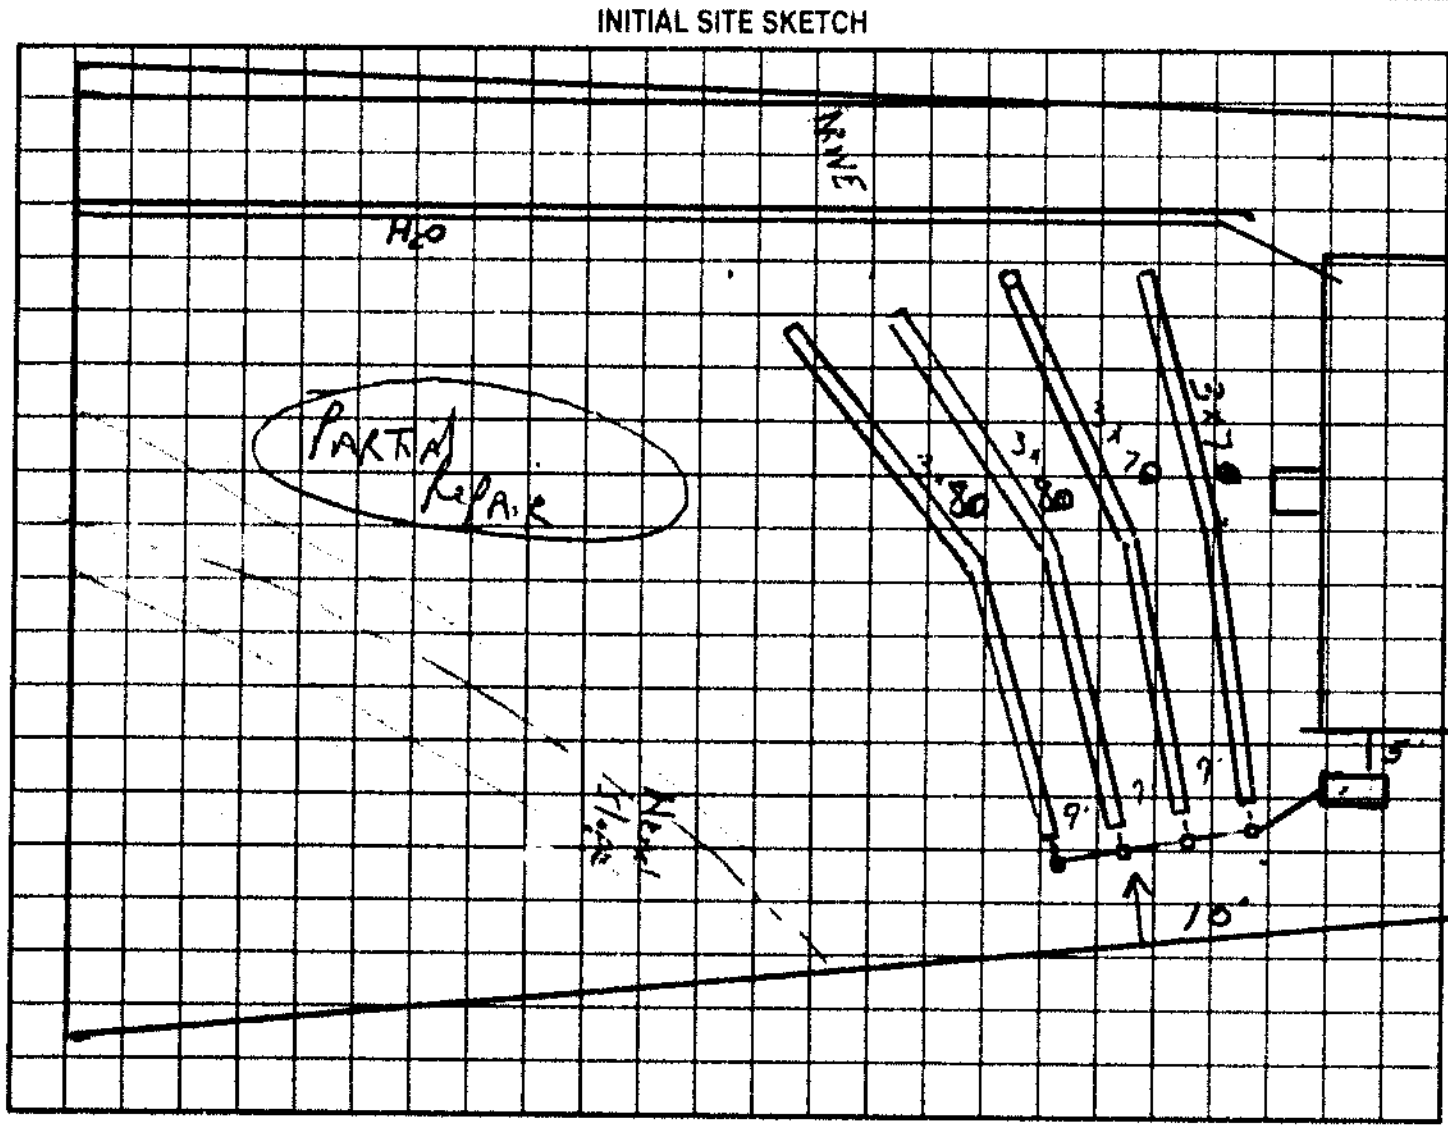

AS BUILT SKETCH

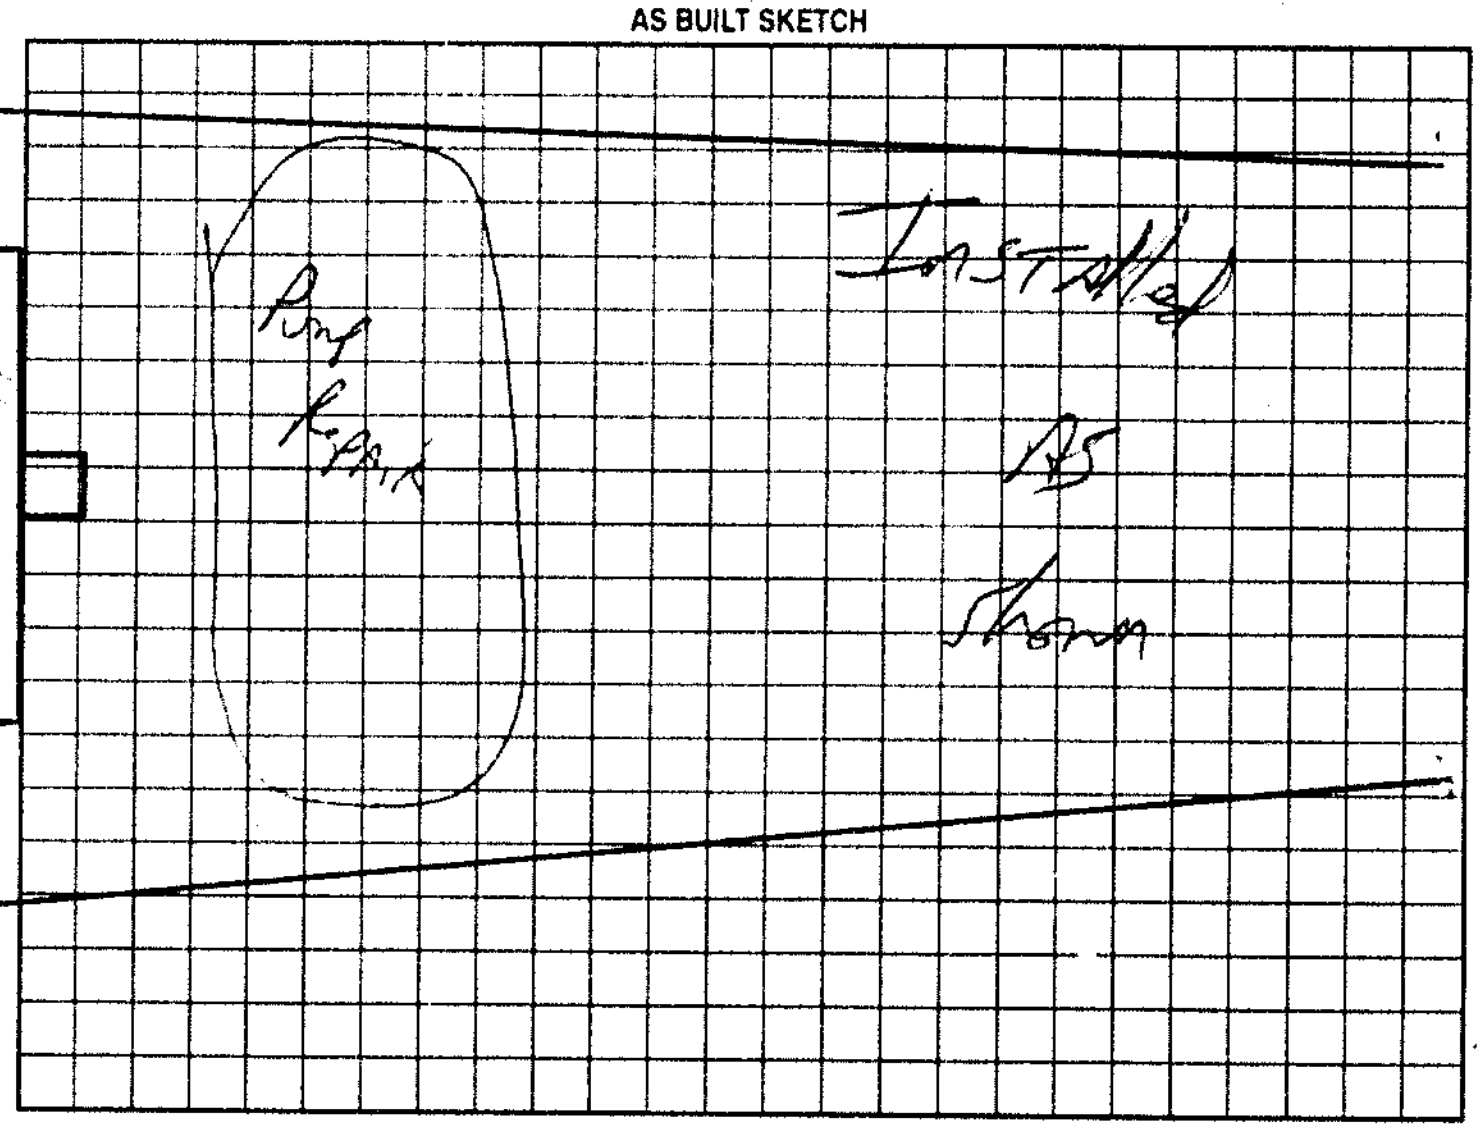

Permit can be suspended or revoked if any false information is supplied toward securing the permit/any unauthorized changes are made to the site/any unauthorized changes are made in the installation of the system. Improvement Permit with plat valid without expiration, Improvement Permit with site plan valid for sixty months. Authorization to Construct is valid for a period equal to that of Improvement Permit – not to exceed sixty months.

Signed: Donna Royal (Oak Creek Vill) date Sept 20 99 Installed by: G & M Ent.

Improvement Permit by: J.C. Potter date Sept 16 99 Operation Permit by: J.C. Potter date Oct 25 99

Authorization to Construct by: J.C. Potter date Sept 16 99 Existing System Inspection by: date

HEALTH DEPT COPY WHITE OWNER COPY (FINAL) YELLOW OWNER COPY (INITIAL) PINK