IREDELL COUNTY HEALTH DEPARTMENT

STATESVILLE 704-878-5305 MOORESVILLE 704-664-5281

IMPROVEMENT PERMIT / AUTHORIZATION TO CONSTRUCT / OPERATION PERMIT / EXISTING SYSTEM INSPECTION

PERMIT# 105110 PIN# 4702-84-2340 DATE 3-19-02

OWNER OR CONTRACTOR KINGS FOREST INC PHONE: Business Home 704-532-6625

ADDRESS 5551 MONROE ROAD, CHARLOTTE NC 28212

LOCATION BUFFALO SHOALS RD, TR EUFOLA RD, TL BARRARY DR, LOT ON LEFT BEFORE COPPER CREEK

SUBDIVISION LANSDOWNE BLOCK / SECTION LOT 13 LOT AREA 1.19 ACRES SITE CLASS. PS DESIGN FLOW 360 L.T.A.R. 0.30 GPD/FT²

Septic Tank: 1000 Gallons; STB 794 Date 03/06/03

Pump Tank: Gallons; PT Date

Pump Make: Model Serial No.

Nitrification Field: No Fields 1 Square Feet 1200 Linear Feet 400

No Lines FIVE Trench Width 36" Max Trench Bottom Depth 36" Gravel Depth 12"

☑ New System ☐ Repair System Type: I (II) III. IV. V. VI

System Description: CONVENTIONAL GRAVITY

Repair System Description: CONVENTIONAL, ~~GRAVITY~~ PUMP

Maintenance Agreement Required: ☐ Yes ☑ No

☐ House/Mod. Home ☑ Mobile Home ☐ Business ☐ Other

No. Bedrooms 3 No. Bathrooms 2 No. Employees

☐ Slab ☑ Crawl Space ☐ Basement w/plumbing ☐ Basement wo/plumbing


Water Supply: ☐ Individual ☑ ~~Public~~ ☐ Community

Comments:/Conditions:


Comments:/Conditions:

- SEPTIC TANK INSTALLED USING ZABEL FILTER + TANK MARKER

INITIAL SITE SKETCH

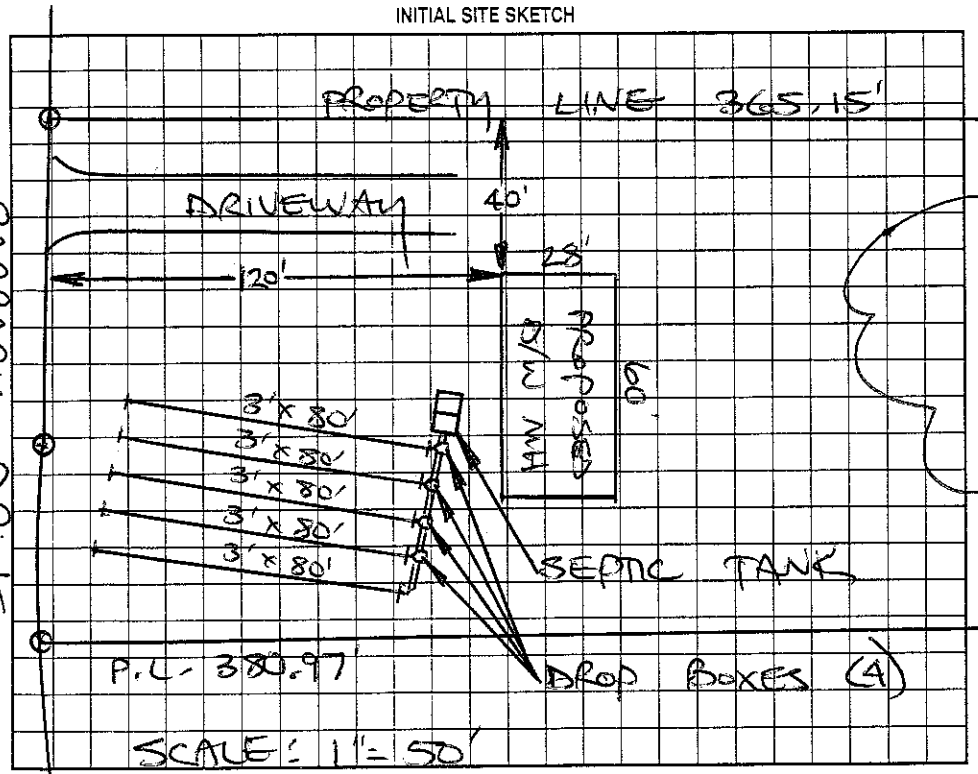

AS BUILT SKETCH

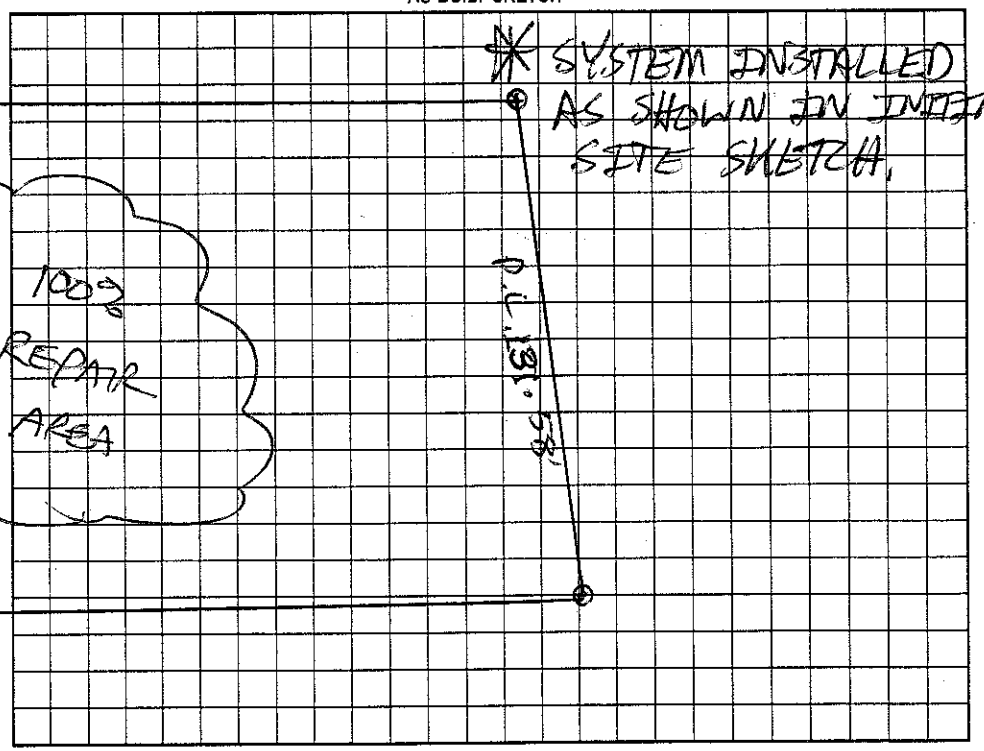

Permit can be suspended or revoked if any false information is supplied toward securing the permit/any unauthorized changes are made to the site/any unauthorized changes are made in the installation of the system. Improvement Permit with plat valid without expiration. Improvement Permit with site plan valid for sixty months. Authorization to Construct is valid for a period equal to that of Improvement Permit – not to exceed sixty months.

Signed: [signature] date 3-19-02 Installed by: JIMMY DELLINGER 03/10/03

Improvement Permit by: STEVE HEDRICK date 3-19-02 Operation Permit by: [signature] date 04/04/03

Authorization to Construct by: STEVE HEDRICK date 3-19-02 Existing System Inspection by: date

HEALTH DEPT. COPY: WHITE OWNER COPY (FINAL): YELLOW OWNER COPY (INITIAL): PINK