IREDELL COUNTY HEALTH DEPARTMENT

STATESVILLE 704-878-5305 MOORESVILLE 704-664-5281

IMPROVEMENT PERMIT / AUTHORIZATION TO CONSTRUCT / OPERATION PERMIT / EXISTING SYSTEM INSPECTION

PERMIT# 80738 PIN# 4702842434 DATE April 28-99

OWNER OR CONTRACTOR Jonathan Berry PHONE: Business Home 873 7027

ADDRESS 150 Henderson DR Statesville

LOCATION Lt 12 Lansdowne Eufola Rd To Barbary Ln on Left

SUBDIVISION Lansdowne BLOCK / SECTION LOT 12 LOT AREA 1.29 SITE CLASS PS DESIGN FLOW 360 L.T.A.R. -3

Septic Tank: 1000 Gallons; STB 786 Date 3 23 99
Pump Tank: Gallons; PT Date
Pump Make: Model Serial No.
Nitrification Field: No Fields 1 Square Feet 1200 Linear Feet 400
No Lines 4 Trench Width 36" Max Trench Bottom Depth 24-30" Gravel Depth 12"

☒ New System ☐ Repair System Type: I II III IV V VI
System Description: Conv. Gravity
Repair System Description: Conv Gravity
Maintenance Agreement Required: ☐ Yes ☒ No

☒ House/Mod. Home No. Bedrooms 3
☐ Mobile Home No. Bathrooms 2
☐ Business No. Employees
☐ Other


☐ Slab ☒ Crawl Space ☐ Basement w/plumbing ☐ Basement wo/plumbing

Water Supply: ☐ Individual ☒ Public ☐ Community


Comments/Conditions: Install Lines on Contour

Comments/Conditions

INITIAL SITE SKETCH

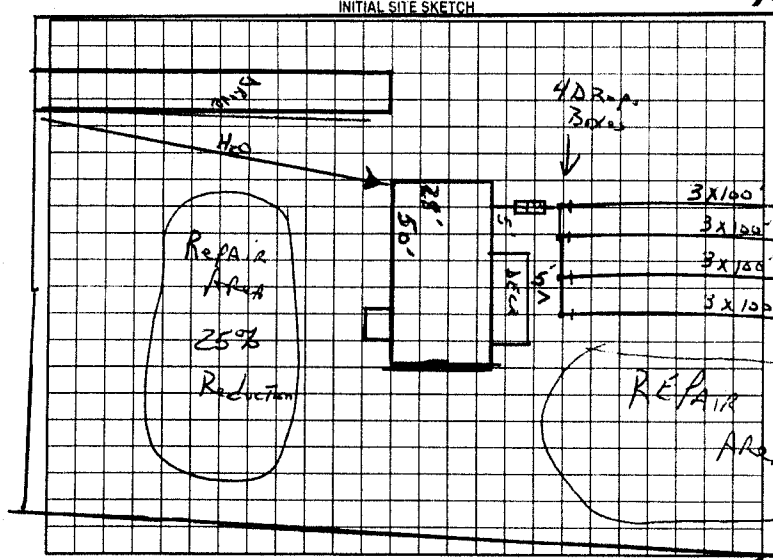

AS BUILT SKETCH

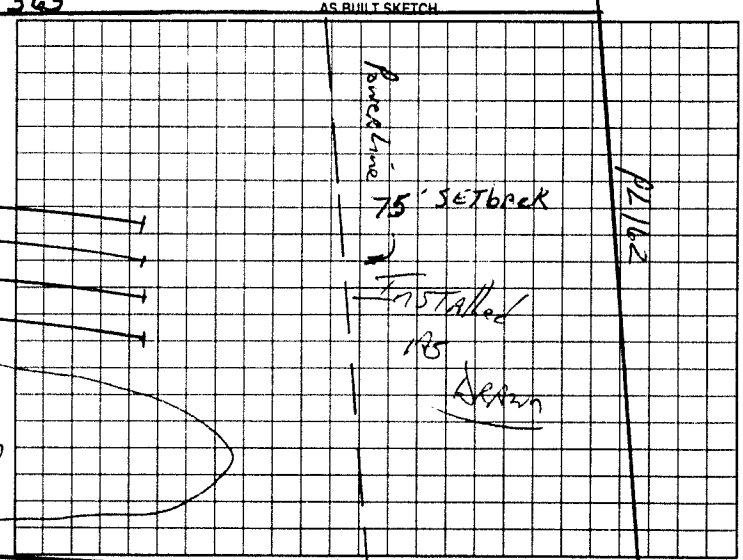

Permit can be suspended or revoked if any false information is supplied toward securing the permit/any unauthorized changes are made to the site/any unauthorized changes are made in the installation of the system. Improvement Permit with plat valid without expiration. Improvement Permit with site plan valid for sixty months. Authorization to Construct is valid for a period equal to that of Improvement Permit - not to exceed sixty months.

Signed: [signature] date 4/28/99 Installed by: S & G Grading

Improvement Permit by: J.C. Potter date 4-28-99 Operation Permit by: J.C. Potter date MAY 28 99

Authorization to Construct by: J.C. Potter date 4-28-99 Existing System Inspection by: date

HEALTH DEPT COPY WHITE OWNER COPY (FINAL) YELLOW OWNER COPY (INITIAL) PINK