IREDELL COUNTY HEALTH DEPARTMENT

STATESVILLE 704-878-5305 MOORESVILLE 704-664-5281

IMPROVEMENT PERMIT / AUTHORIZATION TO CONSTRUCT / OPERATION PERMIT / EXISTING SYSTEM INSPECTION

PERMIT# 81706 PIN# 4702 842 519 DATE Nov 30 99

OWNER OR CONTRACTOR Kings Forest PHONE: Business 532-6625 Home

ADDRESS

LOCATION Old Mt Rd Sth (B) Elevis Ferry (L) ~~Eufola~~ Eufola (R) Barbary Dr Property on left Lot 11

SUBDIVISION Lansdowne BLOCK / SECTION LOT 11 LOT AREA 1.14 Ac SITE CLASS P5 DESIGN FLOW 360 L.T.A.R. .03

Septic Tank: 1000 Gallons; STB 1012 Date 1-22-02
Pump Tank: Gallons; PT Date
Pump Make: Model Serial No.
Nitrification Field: No Fields 1 Square Feet 1200 Linear Feet 360
No Lines 3@100 Trench Width 36" Max Trench Bottom Depth 36" Gravel Depth N/A

☒ New System ☐ Repair System Type: I. II. (III) IV. V. VI
System Description: 25% Reduction Gravity
Repair System Description: ~~Gravity~~ Pump 25-50%
Maintenance Agreement Required: ☐ Yes ☒ No
☐ Slab ☒ Crawl Space ☐ Basement w/plumbing ☐ Basement wo/plumbing


☐ House/Mod. Home ☒ Mobile Home ☐ Business ☐ Other
No. Bedrooms 3 No. Bathrooms 2 No. Employees

Water Supply: ☐ Individual ☒ Public ☐ Community


Comments/Conditions: Install on contour
50 Chambers or 30 HDS Sections
May need to keep Trench bottom shallower than 36"
Surface Diversion ditch need to installed along lower property line

Comments/Conditions:
-Polylok Filter Installed
-S.T. marker Installed 50
Infiltrative Chamber Installed

INITIAL SITE SKETCH

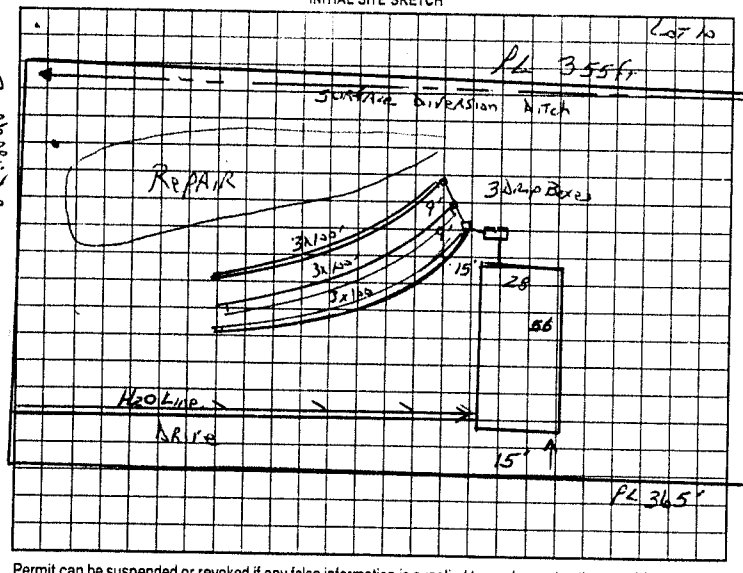

AS BUILT SKETCH

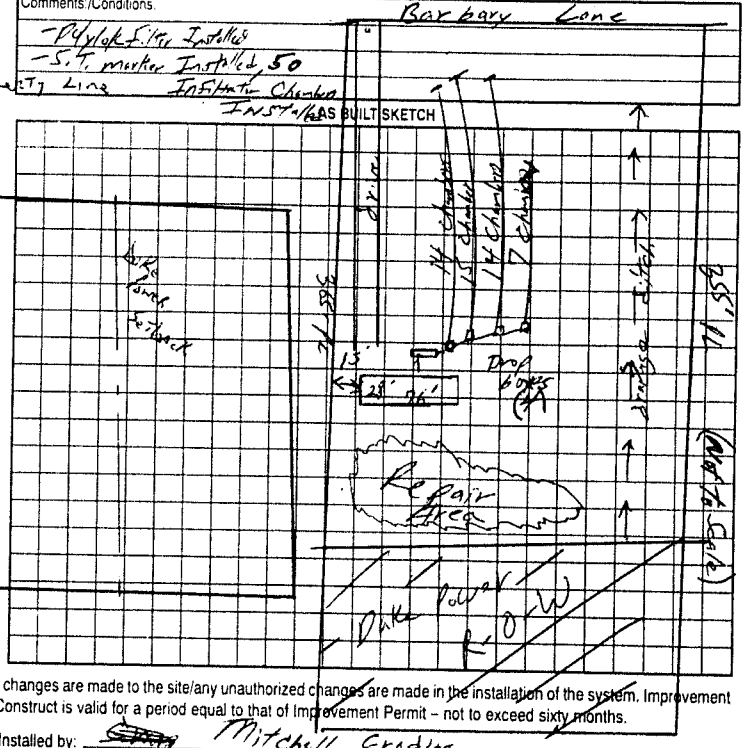

Permit can be suspended or revoked if any false information is supplied toward securing the permit/any unauthorized changes are made to the site/any unauthorized changes are made in the installation of the system. Improvement Permit with plat valid without expiration. Improvement Permit with site plan valid for sixty months. Authorization to Construct is valid for a period equal to that of Improvement Permit – not to exceed sixty months.

Signed: James J. Bracken date 12-1-99 Installed by: ~~Grady~~ Mitchell Grading

Improvement Permit by: J. C. Potter date Nov 30 99 Operation Permit by: Lillian O. Johnson date 5/17/02

Authorization to Construct by: J. C. Potter date Nov 30 99 Existing System Inspection by: date

HEALTH DEPT. COPY: WHITE OWNER COPY (FINAL): YELLOW OWNER COPY (INITIAL): PINK