* THIS PERMIT VOIDS PREVIOUSLY ISSED ON 02/23/01

# IREDELL COUNTY HEALTH DEPARTMENT

STATESVILLE 704-878-5305 MOORESVILLE 704-664-5281

## IMPROVEMENT PERMIT / AUTHORIZATION TO CONSTRUCT / OPERATION PERMIT / EXISTING SYSTEM INSPECTION

PERMIT# 093890 PIN# 4702-85-5081

OWNER OR CONTRACTOR BOYD & PAT MUILLS PHONE: Business _____ DATE 07/09/02

ADDRESS 911 BRAWLEY SCHOOL RD. MOORESVILLE, NC Home 704-662-6475

LOCATION I40W, (TL) Old Mtn Rd, (TR) Celeste-Eufola, (TR) Eufola, (TL) Desiree, on right near end

SUBDIVISION Shenendoah BLOCK / SECTION _____ LOT 12 LOT AREA 2.165 ACRES SITE CLASS PS DESIGN FLOW 480 L.T.A.R. 0.30

Septic Tank: 1,000 Gallons: STB 1012 Date 3-8-02

Pump Tank: _____ Gallons: PT _____ Date _____

Pump Make: _____ Model _____ Serial No _____

Nitrification Field: No Fields 1 Square Feet EQ-1,600 Linear Feet 400

No Lines 4x100' Trench Width 36" Max Trench Bottom Depth 36"

X New System ☐ Repair System Type: I, II, III, IV, V, VI

System Description: 25% Reduction, Gravity

Repair System Description: 25% Reduction, Gravity

Maintenance Agreement Required: ☐ Yes X No

Gravel Depth N/A ☐ Slab X Crawl Space ☐ Basement w/plumbing ☐ Basement wo/plumbing

☐ House/Mod. Home No Bedrooms 4

X Mobile Home No. Bathrooms 2

☐ Business No Employees _____


☐ Other _____

Water Supply: ☐ Individual X Public ☐ Community


Comments/Conditions: (1) Make sure system stays out of Duke Power R/W

Comments/Conditions: 1) POLYLOK FILTER INSTALLED 2) INSTALLED AS DRAWN

INITIAL SITE SKETCH

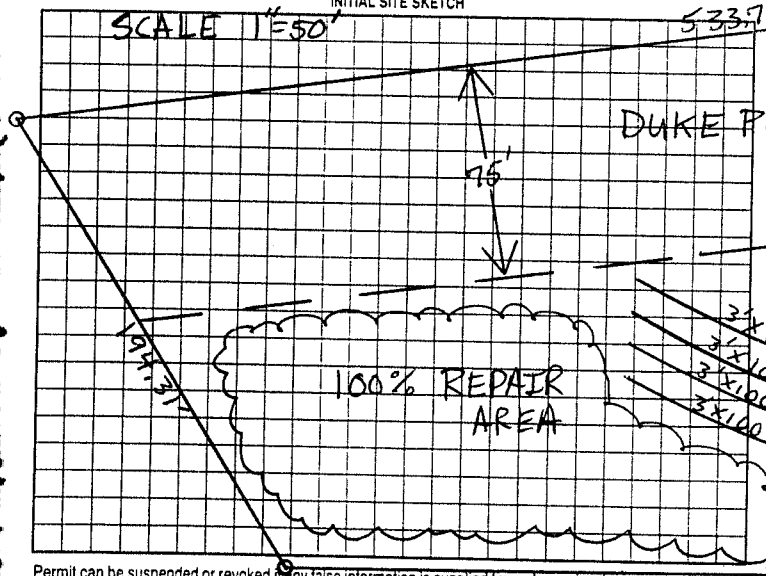


AS BUILT SKETCH

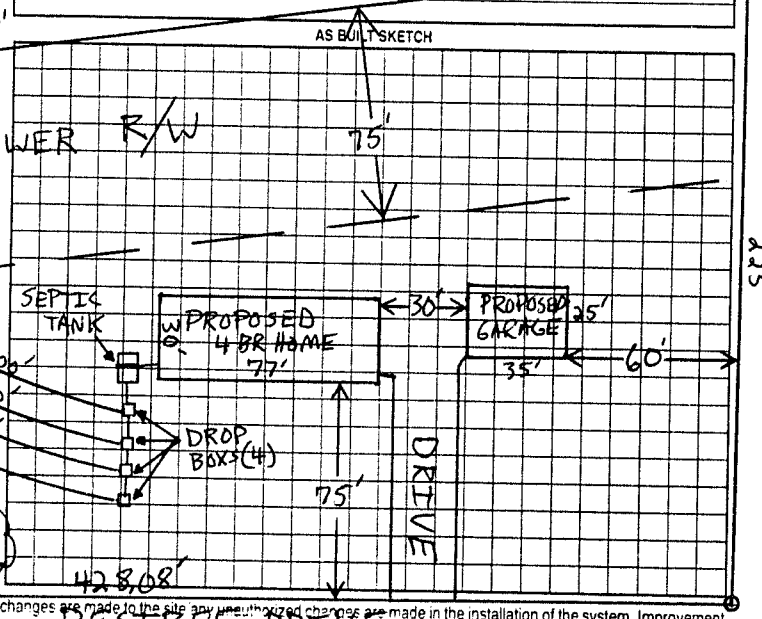


Permit can be suspended or revoked if any false information is supplied toward securing the permit/any unauthorized changes are made to the site any unauthorized changes are made in the installation of the system. Improvement Permit with plat valid without expiration. Improvement Permit with site plan valid for sixty months Authorization to Construct is valid for a period equal to Improvement Permit - not to exceed sixty months

Signed Jane R Noonan date 7/17/02 installed by CRAIG THOMPSON

Improvement Permit by: Patrick Mitchell date 07/09/02 Operation Permit by: C. Bryant RS date 8/1/02

Authorization to Construct by: Patrick Mitchell date 07/09/02 Existing System Inspection by: _____ date _____

HEALTH DEPT COPY: WHITE OWNER COPY (FINAL): YELLOW OWNER COPY (INITIAL): PINK