4BD L/LOD (C1)

IREDELL COUNTY HEALTH DEPARTMENT

STATESVILLE 704-878-5305 MOORESVILLE 704-664-5281

IMPROVEMENT PERMIT / AUTHORIZATION TO CONSTRUCT / OPERATION PERMIT / EXISTING SYSTEM INSPECTION

PERMIT# 139068 PIN# 4702 84 7443 DATE 12-14-06

OWNER OR APPLICANT FULL SPECTRUM HOMES PHONE: Business 704-528-3596 Home

ADDRESS 155-D SOUTH EASTWAY DR TROUTMAN, N.C. 28166

LOCATION 70 WEST (R) EUFOLA (L) DESIREE AT END ON LEFT

SUBDIVISION SHENANDOAH BLOCK / SECTION LOT 9 LOT AREA 1.102 AC SITE CLASS. PS DESIGN FLOW 480 L.T.A.R. .25

Septic Tank: 1000 Gallons: STB 781 Date 9-18-06
Pump Tank: 1000 Gallons: PT 32 Date 9-18-06
Pump Make: ZOELLER Model N-152 B Serial No.
Nitrification Field: No Fields 1 Square Feet 480=480 Linear Feet 320
No Lines 7446 Trench Width 24" Max Trench Bottom Depth 36" Gravel Depth N/A ☐ Gravity ☒ Pressure

☒ New System ☐ Repair ☐ Expansion System Type: I II III IV V VI (B)
System Description: PUMP 50% REDUCT
Repair System Description: LPSD 50% REDUCT
Maintenance Agreement Required: ☐ Yes ☒ No

☐ House/Mod. Home ☒ Mobile Home ☐ Business ☐ Other
No. Bedrooms 4 No. Persons 8 No. Employees


Water Supply: ☐ Individual ☒ Public ☐ Community

☐ Slab ☒ Crawl Space ☐ Basement w/plumbing ☐ Basement wo/plumbing


Comments/Conditions:
(1) SYSTEM & REPAIR FLAGGED OUT COMPLETELY
(2) INSTALL LINES ON CONTOURS & MAINTAIN SETBACKS
(3) CALL Prior to installation For Pump Sizing & System SPECS IF NECESSARY (4) MAINTAIN DRAINAGE WAY

Comments/Conditions: At BACK OF HOME 10' OFF. Keep septic minimum of 15' OFF Drainage WAY.

INITIAL SITE SKETCH 1" = 50'

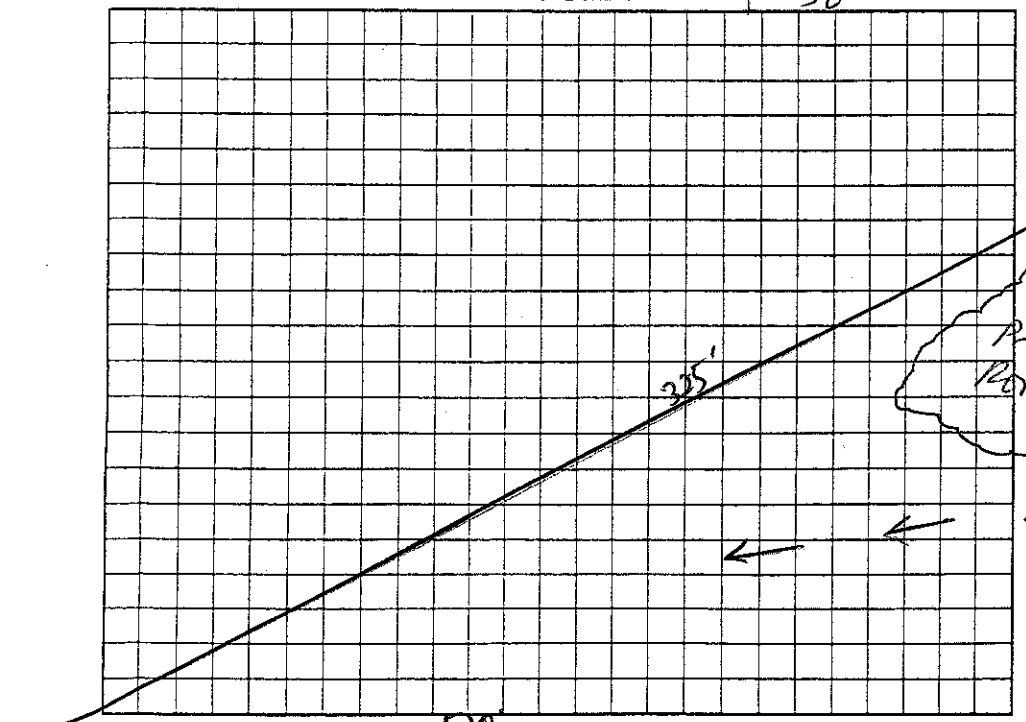

AS BUILT SKETCH

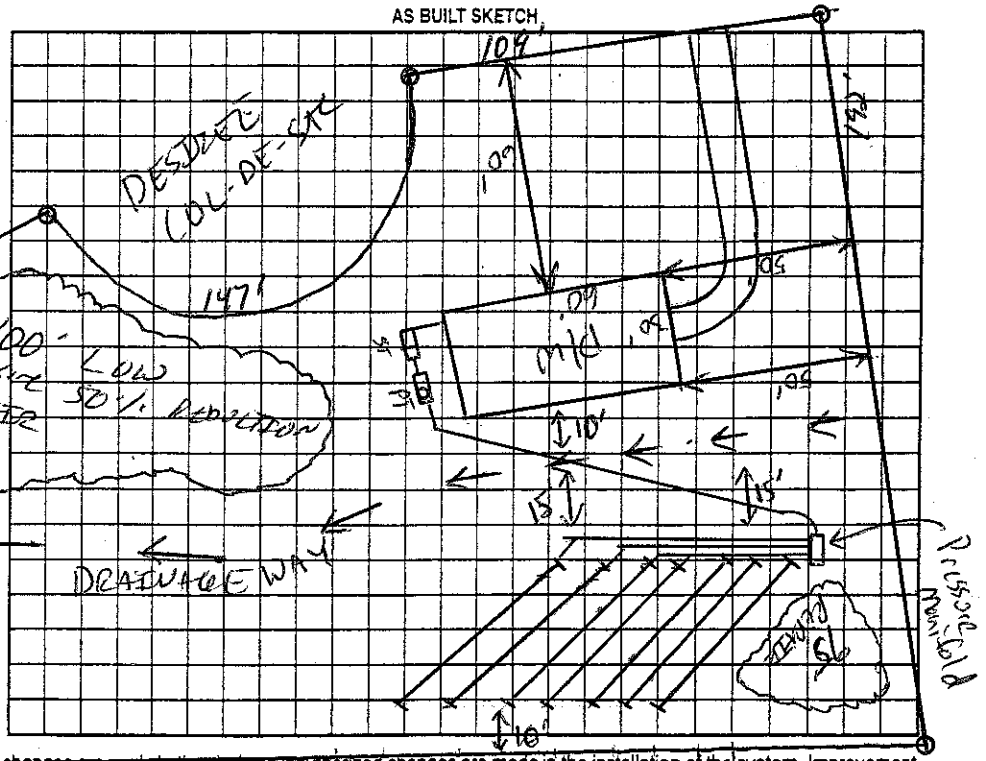

Permit can be suspended or revoked if any false information is supplied toward securing the permit/any unauthorized changes are made to the site/any unauthorized changes are made in the installation of the system. Improvement Permit with plat valid without expiration ☐ Improvement Permit with site plan valid for sixty months ☒

Signed: date 12/18/06

Improvement Permit by: date 12-15-06

Authorization to Construct by: date 12-15-06

Installed by: Puck Smith

Operation Permit by: Jim Hayes, R.S. date 20 Dec 07

Existing System Inspection by: date

HEALTH DEPT. COPY: WHITE OWNER COPY (FINAL): YELLOW OWNER COPY (INITIAL): PINK

